

2 well.

Registration No. GR. 2621

Certificate Nb. GR. 3367

# Registration Statement

## OF CLAIMANT OF RIGHT TO APPROPRIATE GROUND WATER

TO THE STATE ENGINEER OF OREGON:

I, Elaine P. Strame  
of 1425 Highway 99E Junction City County of Polk  
(Mailing address)

State of Oregon, do hereby make application for a certificate of registration as evidence of a right to appropriate ground water.

1. Source from which water is withdrawn is pump well  
(Flowing well, pump well, infiltration trench, or tunnel)

2. Location is: 2 miles North of Junction City  
(Approximate distance and direction from nearest city or town)

and is more particularly described as follows:

(a) 5700' S 35° W from NE corner of Sec 20  
(Give distance and bearing to corner of section or other legal subdivision)

being within S.E. 1/4 S.W. 1/4 of Sec. 20, Twp. 15 S, Rge. 4 W  
(Smallest legal subdivision) (N. or S.) (E. or W.)

or (b) within limits of recorded platted property, town or city:

in Lot \_\_\_\_\_, Block \_\_\_\_\_ of \_\_\_\_\_  
(Name of plat or addition)

County of \_\_\_\_\_  
(If within city or town, give name)

3. Construction Work was begun on 1938; was completed on 1938  
(Date) (Date)

and the ground water claimed was first used for the purposes set out below on 1938  
(Date)

since which time the water has been used intermittently  
(Continuously or intermittently)

from 1938 to July 1958  
(Date) (Date)

4. Quantity of water claimed and used is 650 gallons per minute; 116 acre feet per year.

5. Purpose or Purposes for which water is used irrigation  
(Domestic, irrigation, municipal, manufacturing, industrial, etc.)

6. Description of Well: Depth 21 feet. Type driven  
(Dug or drilled)

diameter 4 inches. Elevation of ground at well site 300 feet, mean sea level.  
(As near as known)

Depth to water table 10 feet.

7. Capacity of Well: 650 g.p.m. with 4 feet drawdown;

0 g.p.m. with 0 feet drawdown.

Date of test \_\_\_\_\_

If Flowing Well: Measured discharge \_\_\_\_\_ g.p.m. on \_\_\_\_\_  
(Date)


Shut-in pressure at ground surface \_\_\_\_\_ lbs. per sq. in. on \_\_\_\_\_  
(Date)

Water is controlled by \_\_\_\_\_  
(Cap, valve, etc.)





Township 15S Range 4W, W.M.  
North

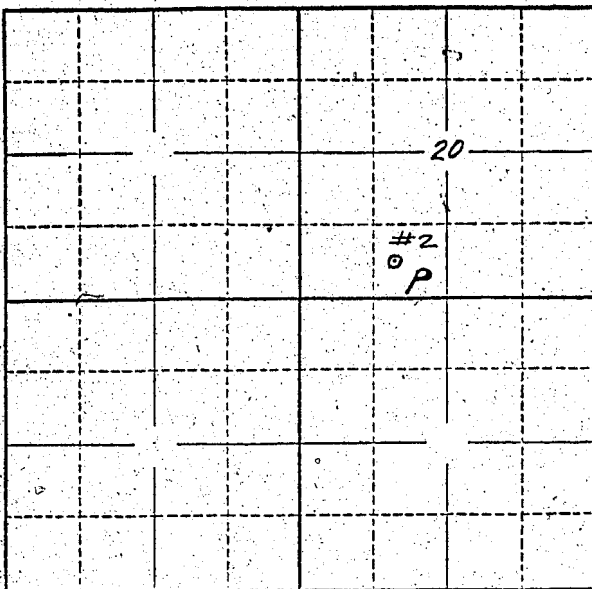

Locate well and acreage of irrigated land on plat.  
Scale: 2" = 1 Mile

STATE OF OREGON

County of Linn } ss.

I, Elvie P. Strome, being first duly sworn, do hereby certify that I have read the foregoing Registration Statement and that all of the items therein contained are true to the best of my knowledge and belief.

Elvie P. Strome  
(Signature of Registrant)

Subscribed and sworn to before me this 28<sup>th</sup> day of July, 1958

My commission expires April 11, 1960

John S. Steinhart  
(Notary Public)

(SEAL)

**CERTIFICATE OF REGISTRATION**

STATE OF OREGON

County of Marion } ss.

This is to certify that the foregoing Registration Statement was received in the office of the State Engineer on the 15<sup>th</sup> day of August, 1958, at 2:00 o'clock A. M. and has been duly recorded in said office in Book No. 14 of Registration Statements on page GR-3367

Witness my hand this 20<sup>th</sup> day of August, 1959

Leura A. Stanley  
(State Engineer)

By \_\_\_\_\_ (Deputy)

\$ 25.65

GR-3367