

Registration Statement

OF CLAIMANT OF RIGHT TO APPROPRIATE GROUND WATER

TO THE STATE ENGINEER OF OREGON:

I, Ray Kitcheloe
of Route 2 Box 752 BEAVERTON, County of Washington
(Mailing address)

State of Oregon, do hereby make application for a certificate of registration as evidence of a right to appropriate ground water.

- 1. Source from which water is withdrawn is Pump Well
(Flowing well, pump well, infiltration trench, or tunnel)
- 2. Location is: Two Miles South of Reedville
(Approximate distance and direction from nearest city or town)

and is more particularly described as follows:

(a) 2970' 542.0'E From NW corner Sec 23
(Give distance and bearing to corner of section or other legal subdivision)
being within SE 1/4 of NW 1/4 of Sec. 23, Twp. 15, Rge. 2W
(Smallest legal subdivision) (N. or S.) (E. or W.)

or (b) within limits of recorded platted property, town or city:
in Lot _____, Block _____ of _____
(Name of plat or addition)

County of _____
(If within city or town, give name)

- 3. Construction Work was begun on 1932; was completed on 1932
(Date) (Date)

and the ground water claimed was first used for the purposes set out below on 1933
(Date)

since which time the water has been used Continuously
(Continuously or intermittently)

from 1933 to 1958
(Date) (Date)

- 4. Quantity of water claimed and used is 80.0 gallons per minute; _____ acre feet per year.

- 5. Purpose or Purposes for which water is used Domestic + Irrigation
(Domestic, irrigation, municipal, manufacturing, industrial, etc.)

6. Description of Well: Depth 337 feet. Type Drilled
(Dug or drilled)
diameter 6" inches. Elevation of ground at well site about 200' feet, mean sea level.
(As near as known)
Depth to water table 40 to 50' feet.

- 7. Capacity of Well: UNKNOWN g.p.m. with UNKNOWN feet drawdown,
_____ g.p.m. with _____ feet drawdown.


Date of test _____

If Flowing Well: Measured discharge _____ g.p.m. on _____
(Date)

Shut-in pressure at ground surface _____ lbs. per sq. in. on _____
(Date)

Water is controlled by _____
(Cap, valve, etc.)

Township 15 Range 24 W.M.
North

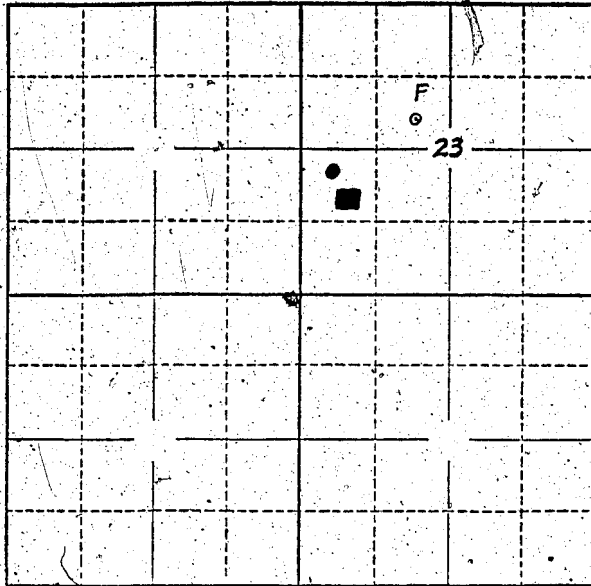

Locate well and acreage of irrigated land on plat.
Scale: 2" = 1 Mile

STATE OF OREGON

County of Multnomah } ss.

I, Ray Kinchelse, being first duly sworn, do hereby certify that I have read the foregoing Registration Statement and that all of the items therein contained are true to the best of my knowledge and belief.

Ray Kinchelse
(Signature of Registrant)

Subscribed and sworn to before me this 31 day of July, 1958

My Commission expires My Commission Expires Jan. 13, 1962

Charles W. Hawkins
(Notary Public)

(SEAL)

CERTIFICATE OF REGISTRATION

STATE OF OREGON

County of Marion } ss.

This is to certify that the foregoing Registration Statement was received in the office of the State Engineer on the August day of 1958, at 4:00 o'clock A. M. and has been duly recorded in said office in Book No. 14 of Registration Statements on page GR- 3375

Witness my hand this 20th day of August, 1959

Lewis A. Stanley
(State Engineer)

By _____
(Deputy)

GR - 3375

#15.00