

# Registration Statement

## OF CLAIMANT OF RIGHT TO APPROPRIATE GROUND WATER

RECEIVED  
JAN 20 1950

TO THE STATE ENGINEER OF OREGON:

I, Robin D. Day and Janice E. Day

of Rt. 2, Box 87  
(Mailing address)

County of Marion

State of Oregon, do hereby make application for a certificate of registration as evidence of a right to appropriate ground water.

1. Source from which water is withdrawn is PUMP well #1  
(Flowing well, pump well, infiltration trench, or tunnel)

2. Location is: North of Salem and 7 miles from Ladd & Bush Bank, Salem  
(Approximate distance and direction from nearest city or town)

and is more particularly described as follows:

(a) 1400 feet north & 700 feet west from S.E. corner of Section 21  
(Give distance and bearing to corner of section of other legal subdivision)

being within NE 1/4 S.E. 4 of Sec. 21, Twp. 5 S., Rge. 3 W.  
(Small legal subdivision) (T. or S.) (E. or W.)

or (b) within limits of recorded platted property, town or city:

in Lot \_\_\_\_\_, Block \_\_\_\_\_ of \_\_\_\_\_  
(Name of plat or addition)

County of \_\_\_\_\_  
(If within city or town, give name)

3. Construction Work was begun on April, 1922; was completed on April, 1922  
(Date) (Date)

and the ground water claimed was first used for the purposes set out below on summer of 1922  
(Date) since which time the water has been used intermittently from 1922 to and including 1958  
(Continuously or intermittently) from 1922 to 1958  
(Date) (Date)

4. Quantity of water claimed and used is 300 gallons per minute; \_\_\_\_\_ acre feet per year. Depends on the year and the kind of crops on it.

5. Purpose or Purposes for which water is used irrigation

(Domestic, irrigation, municipal, manufacturing, industrial, etc.)

6. Description of Well: Depth 40 feet. Type drill  
(Dug or drilled) diameter 10" inches. Elevation of ground at well site 100 feet, mean sea level.  
(As near as known) Depth to water table 40' feet.

7. Capacity of Well: 300 g.p.m. with no feet drawdown.  
\_\_\_\_\_ g.p.m. with \_\_\_\_\_ feet drawdown.

Date of test every year when pumps are put in.

If Flowing Well: Measured discharge \_\_\_\_\_ g.p.m. on \_\_\_\_\_  
(Date)

Shut-in pressure at ground surface \_\_\_\_\_ lbs. per sq. in. on \_\_\_\_\_  
(Date)

Water is controlled by \_\_\_\_\_  
(Cap, valve, etc.)

8. Casing: (Give diameter, commercial specifications and depth below ground surface of each casing size.)

12 inch diameter from top to 30 feet  
 inch diameter from to feet  
 inch diameter from to feet  
 inch diameter from to feet

Describe and show depth of shoe, plug, adapter, liner or other details:

9. Perforated Casings or Screens:

Screens at bottom from to  
 (Number per-foot and size of perforations, or describe screen)  
 from to  
 from to  
 from to

10. Log of Well: (Describe each stratum or formation clearly, indicate if water bearing, and give thickness and depth as indicated.)

MATERIAL	Thickness (Feet)	Depth to Bottom (Feet)
Plain river bottom soil	30	
then sand and gravel		

If log of well is not available, give name and address of driller. unknown

11. Infiltration Trench:  Covered or open  \_\_\_\_\_

Dimensions: Length  \_\_\_\_\_ ft. Minimum depth \_\_\_\_\_ ft. Maximum depth \_\_\_\_\_ ft.

Bottom width \_\_\_\_\_ ft. Discharge \_\_\_\_\_ g.p.m. Date of test \_\_\_\_\_

12. Tunnel: Type of lining \_\_\_\_\_

Dimensions: \_\_\_\_\_  
(Length, course, and cross sectional size)

Position of water bearing stratum with reference to portal of tunnel \_\_\_\_\_

Log of tunnel: (Preceding table for log of well may be used, if desired. Give footage from portal and character of materials, as pertinent.)

13. Pumping Equipment:

(a) Pump Unknown \_\_\_\_\_ Capacity 300 g.p.m.  
(Make, type and size)


(b) Motor 15 horsepower \_\_\_\_\_  
(Type and horsepower)

14. Location of area irrigated or to be irrigated, or place of use if for purposes other than irrigation.

Township North or South	Range E. or W. of Willamette Meridian	Section	Forty-acre Tract	Number Acres To Be Irrigated	Date of Reclamation
T5 3	3 W	21	<del>SE 1/4 of NE 1/4</del>	29 Total	1090
"	"	"	SE 1/4 of NE 1/4	5 <sup>00</sup>	"
"	"	"	NE 1/4 of SE 1/4	11 <sup>00</sup>	"
"	"	"	SE 1/4 of SE 1/4	13 <sup>00</sup>	"
				<u>29<sup>00</sup> Total</u>	

15. If the ground water supply is supplemental to an existing water supply, identification of any application for a permit, permit, certificate or adjudicated right to appropriate water made or held by the registrant.

Township 6S Range 3W W.M.  
North

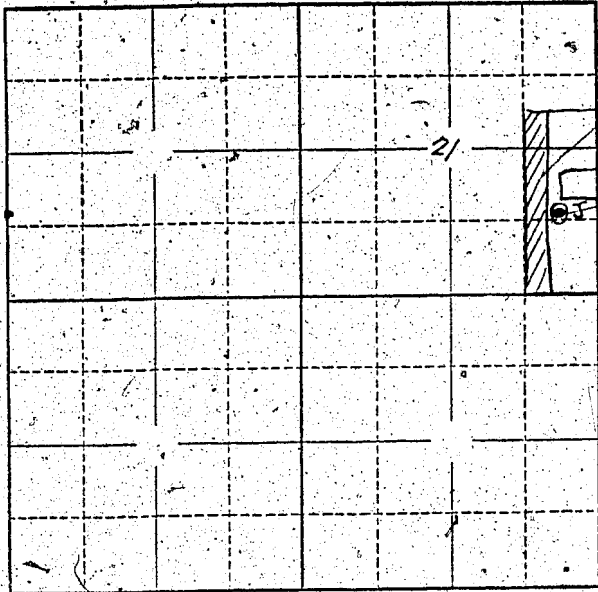

Locate well and acreage of irrigated land on plat.  
Scale: 2" = 1 Mile

STATE OF OREGON }  
County of Marion } ss.

I, Robin D. Day, being first duly sworn, do hereby certify that I have read the foregoing Registration Statement and that all of the items therein contained are true to the best of my knowledge and belief.

*Robin D. Day*  
(Signature of Registrant)

Subscribed and sworn to before me this 31st day of July, 19 58

My commission expires 9/25/59

*Bruce C. ...*  
(Notary Public)

(SEAL)

**CERTIFICATE OF REGISTRATION**

STATE OF OREGON }  
County of Marion } ss.

This is to certify that the foregoing Registration Statement was received in the office of the State Engineer on the 1 day of August, 19 58, at 2:00 o'clock P.M. and has been duly recorded in said office in Book No. 16 of Registration Statements on page GR 3912

Witness my hand this 15th day of February, 19 60

*State Engineer*  
(State Engineer)

By \_\_\_\_\_  
(Deputy)

GR 3912