

Registration Statement

OF CLAIMANT OF RIGHT TO APPROPRIATE GROUND WATER

TO THE STATE ENGINEER OF OREGON:

I, Lawrence C. Andersen
of 5418 Windsor Tr. Rd., Salem County of Marion
(Mailing address)

State of Ore do hereby make application for a certificate of registration as evidence of a right to appropriate ground water.

1. Source from which water is withdrawn is Pump Well
(Flowing well, pump well, infiltration trench, or tunnel)

2. Location is: 5 miles N.W. of Salem, Ore
(Approximate distance and direction from nearest city or town)

and is more particularly described as follows:

(a) 1090 feet south & 450 feet west from center of Section 34, T6S, R3W
(Give distance and bearing to corner of section or other legal subdivision)

being within NE 1/4 of SW 1/4 of Sec. 34, Twp. 6S, Rge. 3W
(Smallest legal subdivision) (T or S) (R or W)

or (b) within limits of recorded platted property, town or city:

in Lot _____, Block _____ of _____
(Name of plat or addition)

County of _____
(If within city or town, give name)

3. Construction Work was begun on April '48, was completed on April '48
(Date) (Date)

and the ground water claimed was first used for the purposes set out below on April '48
(Date)

since which time the water has been used Continuously
(Continuously or intermittently)

from April 1948 to July 30, 1958
(Date) (Date)

4. Quantity of water claimed and used is 200 gallons per minute; _____ acre feet per year.

5. Purpose or Purposes for which water is used Domestic - Irrigation Orchard Spraying
(Domestic, irrigation, municipal, manufacturing, industrial, etc.)

6. Description of Well: Depth 39 1/2 feet. Type Drilled
(Dug or drilled)
diameter 6 inches. Elevation of ground at well site 160 feet, mean sea level.
(As near as known)
Depth to water table 7 1/2 feet.

7. Capacity of Well: ~~200~~ g.p.m. with _____ feet drawdown.
never tested g.p.m. with _____ feet drawdown.


Date of test _____

If Flowing Well: Measured discharge _____ g.p.m. on _____
(Date)

Shut-in pressure at ground surface _____ lbs. per sq. in. on _____
(Date)

Water is controlled by _____
(Cap, valve, etc.)

Township ~~65~~ Range 3 W W.M.
North

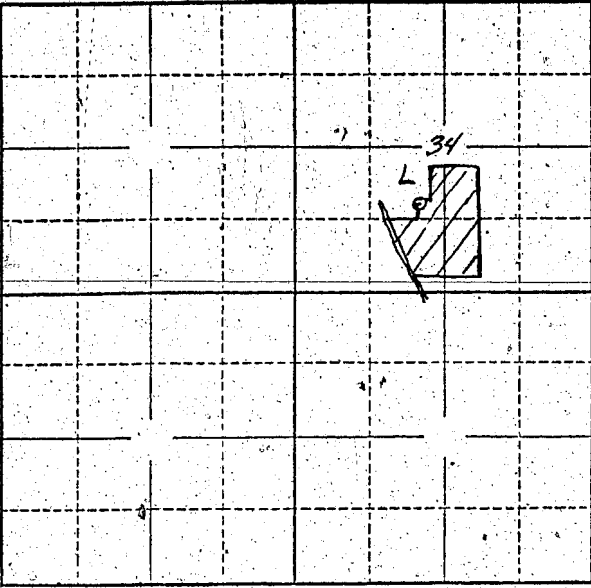

Locate well and acreage of irrigated land on plat.
Scale: 2" = 1 Mile

STATE OF OREGON }
County of Marion } ss.

I, _____, being first duly sworn, do hereby certify that I have read the foregoing Registration Statement and that all of the items therein contained are true to the best of my knowledge and belief.

Laurie C. Anderson
(Signature of Registrant)

Subscribed and sworn to before me this 31 day of July, 1958.

My commission expires Sept 25, 1960 Evangeline M. Meyer
(Notary Public)

(SEAL)

CERTIFICATE OF REGISTRATION

STATE OF OREGON }
County of Marion } ss.

This is to certify that the foregoing Registration Statement was received in the office of the State Engineer on the 1st day of August, 1958, at 8:20 o'clock A.M. and has been duly recorded in said office in Book No. 14 of Registration Statements on page GR-3376

Witness my hand this 20th day of August, 1959.

Lewis A. Stanley
(State Engineer)

By _____
(Deputy)

#1590