

Rec. June 19, 1966  
W.S.B. - 11cu of last statement.

# Registration Statement

Registration No. GR-3689  
Certificate No. GR. 4152

## OF CLAIMANT OF RIGHT TO APPROPRIATE GROUND WATER

TO THE STATE ENGINEER OF OREGON:

I, Edwin Koach and Virginia Koach DBA Prairie Farms  
of 1005 Capitol Towers, Salem County of Marion  
(Mailing address)

State of Oregon, do hereby make application for a certificate of registration as evidence of a right to appropriate ground water.

1. Source from which water is withdrawn is pump well  
(Flowing well, pump well, infiltration trench, or tunnel)

2. Location is: approx. 4 miles North of Marion; approx. 6 miles West of  
Steyton; 5 Miles South of Turner,  
(Approximate distance and direction from nearest city or town)  
and is more particularly described as follows:

(a) 2100 ft North and 2250 feet West of SE Cor. Section 15  
(Give distance and bearing to corner of section or other legal subdivision)

being within NW 1/4 SE 1/4 of Sec. 15, Twp. 9S, Rge. 2 W  
(Smallest legal subdivision) (North S.) (Block W.)

or (b) within limits of recorded platted property, town or city: \_\_\_\_\_

in Lot \_\_\_\_\_, Block \_\_\_\_\_ of \_\_\_\_\_  
(Name of plat or addition)

\_\_\_\_\_ County of \_\_\_\_\_  
(If within city or town, give name)

3. Construction Work was begun on approx. 1944; was completed on 1944  
(Date) (Date)

and the ground water claimed was first used for the purposes set out below on 1944  
(Date)

since which time the water has been used continuously  
(Continuously or intermittently)

from 1944 to 1966  
(Date) (Date)

4. Quantity of water claimed and used is 20 gallons per minute; \_\_\_\_\_ acre feet per year.

5. Purpose or Purposes for which water is used Domestic and Irrigation

(Domestic, irrigation, municipal, manufacturing, industrial, etc.)

6. Description of Well: Depth approx. 61 feet. Type drilled  
(Dug or drilled)

diameter 6 inches. Elevation of ground at well site \_\_\_\_\_ feet, mean sea level.  
(As near as known)

Depth to water table 10 feet.

7. Capacity of Well: \_\_\_\_\_ g.p.m. with \_\_\_\_\_ feet drawdown.

\_\_\_\_\_ g.p.m. with \_\_\_\_\_ feet drawdown.

Date of test \_\_\_\_\_

If Flowing Well: Measured discharge \_\_\_\_\_ g.p.m. on \_\_\_\_\_  
(Date)

Shut-in pressure at ground surface \_\_\_\_\_ lbs. per sq. in. on \_\_\_\_\_  
(Date)

Water is controlled by \_\_\_\_\_  
(Cap, valve, etc.)

8. Casing: (Give diameter, commercial specifications and depth below ground surface of each casing size.)

6 inch diameter Close to bottom from ..... to ..... feet  
 ..... inch diameter ..... from ..... to ..... feet  
 ..... inch diameter ..... from ..... to ..... feet  
 ..... inch diameter ..... from ..... to ..... feet

Describe and show depth of shoe, plug, adapter, liner or other details: .....

9. Perforated Casings or Screens:

..... from ..... to .....  
(Number per foot and size of perforations, or describe screen)  
No Perforations ..... from ..... to .....  
 ..... from ..... to .....  
 ..... from ..... to .....

10. Log of Well: (Describe each stratum or formation clearly, indicate if water bearing, and give thickness and depth as indicated.)

MATERIAL	Thickness (Feet)	Depth to Bottom (Feet)
I do not have Log.		

If log of well is not available, give name and address of driller. Wymore & West

11. Infiltration Trench: Covered or open .....

Dimensions: Length ..... ft. Minimum depth ..... ft. Maximum depth ..... ft.

Bottom width ..... ft. Discharge ..... g.p.m. Date of test .....

12. Tunnel: Type of lining .....

Dimensions: .....  
(Length, course, and cross sectional size)

Position of water bearing stratum with reference to portal of tunnel .....

Log of tunnel: (Preceding table for log of well may be used, if desired. Give footage from portal and character of materials, as pertinent.)

13. Pumping Equipment:

(a) Pump 1 hp. Jacuzzi Deep Well Pump Capacity ..... g.p.m.  
(Make, type and size)


(b) Motor electric .....  
(Type and horsepower)

14. Location of area irrigated or to be irrigated, or place of use if for purposes other than irrigation.

Township North or South	Range E. or W. of Willamette Meridian	Section	Forty-acre Tract	Number Acres To Be Irrigated	Date of Reclamation
Location of well marked on map marked Exhibit "A" and by reference made a part hereof; Also attached to application. We irrigate from this well approximately 500 feet each direction, or a total of 10 acres.					
<u>T9S</u>	<u>R2W</u>	<u>15</u>	<u>NW 1/4 SE 1/4</u>	<u>10.0</u>	<u>1944</u>

15. If the ground water supply is supplemental to an existing water supply, identification of any application for a permit, permit, certificate or adjudicated right to appropriate water made or held by the registrant.

Township 9S Range 2W W.M.  
North

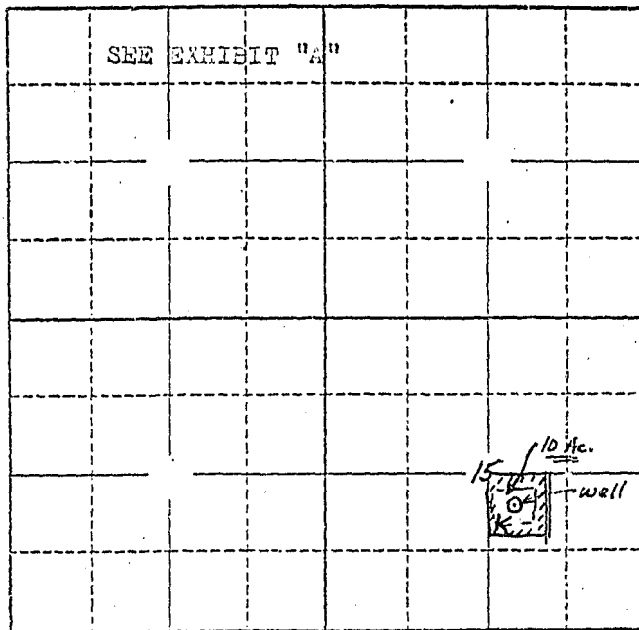

Locate well and acreage of irrigated land on plat.  
Scale: 2" = 1 Mile

STATE OF OREGON }  
County of MARION } ss.

I, Edwin Leach & Virginia Leach, being first duly sworn, do hereby certify that I have read the foregoing Registration Statement and that all of the items therein contained are true to the best of my knowledge and belief.

Edwin Leach  
Virginia Leach  
(Structure of Registrant)

Subscribed and sworn to before me this 10 day of June, 1966.

My commission expires 8-21-66  
Victor H. Boe  
(Notary Public)

(SEAL)

**CERTIFICATE OF REGISTRATION**

*This statement filed in lieu of original-lost: wsb 4/20/66*

STATE OF OREGON }  
County of Marion } ss.

This is to certify that the foregoing Registration Statement was received in the office of the State Engineer on the 15th day of June, 1966, at 2:20 o'clock P. M. and has been duly recorded in said office in Book No. 17 of Registration Statements on page GR-4152

Witness my hand this 5th day of August, 1966.

Victor H. Boe  
(State Engineer)

By \_\_\_\_\_ (Deputy)

\$15.00

GR 4152