

Registration Statement

OF CLAIMANT OF RIGHT TO APPROPRIATE GROUND WATER

TO THE STATE ENGINEER OF OREGON:

I, REX P. Swearingen
of 885 VISTA AVE SALEM County of MARION
(Mailing Address)

State of Oregon, do hereby make application for a certificate of registration as evidence of a right to appropriate ground water.

1. Source from which water is withdrawn is PUMP
(Flowing well, pump well, infiltration trench, or tunnel)

2. Location is: 1 mile from west Salem
(Approximate distance and direction from nearest city or town)

and is more particularly described as follows:

(a) 3965' S & 1300' E from N 1/4 corner Section 29
(Give distance and bearing to corner of section or other legal subdivision)

being within SW 1/4 SE 1/4 of Sec. 29, Twp. 7S, Rge. 3W
(Smallest legal subdivision) (N. or S.) (E. or W.)

or (b) within limits of recorded platted property, town or city:

in Lot _____, Block _____ of _____
(Name of plat or addition)

County of Polk
(If within city or town, give name)

3. Construction Work was begun on 1949; was completed on 1949
(Date) (Date)

and the ground water claimed was first used for the purposes set out below on 1949
(Date)

since which time the water has been used INTERMITTENTLY
(Continuously or intermittently)

from 1949 to 1958
(Date) (Date)

4. Quantity of water claimed and used is 150 gallons per minute; _____ acre feet per year.

5. Purpose or Purposes for which water is used IRRIGATION

(Domestic, irrigation, municipal, manufacturing, industrial, etc.)

6. Description of Well: Depth 33 feet. Type DRILLED
(Dug or drilled)

diameter 8" inches. Elevation of ground at well site _____ feet, mean sea level.
(As near as known)

Depth to water table 17' feet.

7. Capacity of Well: _____ g.p.m. with _____ feet drawdown.

_____ g.p.m. with _____ feet drawdown.

Date of test _____


If Flowing Well: Measured discharge _____ g.p.m. on _____
(Date)

Shut-in pressure at ground surface _____ lbs. per sq. in. on _____
(Date)

Water is controlled by _____
(Cap, valve, etc.)

Township 775 Range R-3W, W.M.

North

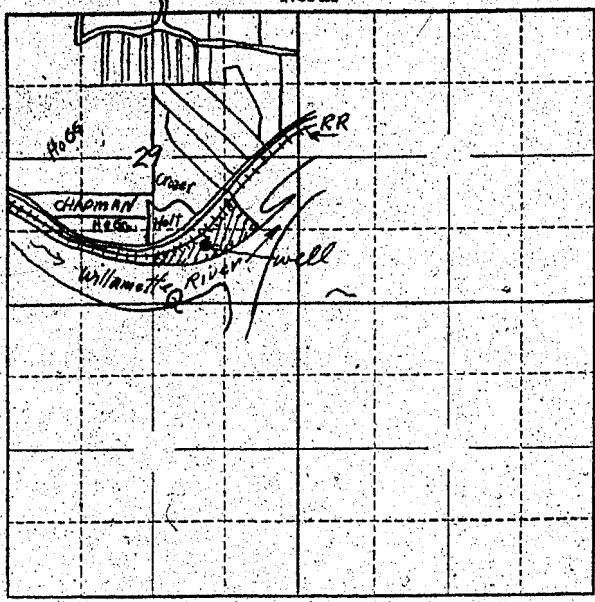

Locate well and acreage of irrigated land on plat.
Scale: 2" = 1 Mile

STATE OF OREGON

County of _____ } ss.

I, _____, being first duly sworn, do hereby certify that I have read the foregoing Registration Statement and that all of the items therein contained are true to the best of my knowledge and belief.

Ray P. Sweetrigen
(Signature of Registrant)

Subscribed and sworn to before me this 2 day of May, 1960

My commission expires Feb 2, 1963
David Jones
(Notary Public)

(SEAL)

CERTIFICATE OF REGISTRATION

STATE OF OREGON

County of Marion } ss.

This is to certify that the foregoing Registration Statement was received in the office of the State Engineer on the 1st day of August, 1958, at 1:45 o'clock A.M. and has been duly recorded in said office in Book No. 17 of Registration Statements on page GR-4084

Witness my hand this 16th day of May, 1960

LEWIS A. STANLEY
(State Engineer)

By Max F. Rogers
(Deputy)

\$15.00

GR 4084