

Registration Statement

OF CLAIMANT OF RIGHT TO APPROPRIATE GROUND WATER

TO THE STATE ENGINEER OF OREGON:

I, LEONARD H. MARCUM AND EILEEN P. MARCUM OR HEIRS
of B.T. JEFFERSON County of MARION
(Mailing address)

State of OREGON, do hereby make application for a certificate of registration as evidence of a right to appropriate ground water.

1. Source from which water is withdrawn is PUMP WELL
(Flowing well, pump well, infiltration trench, or tunnel)

2. Location is: 1 1/2 mi. S.E. of JEFFERSON on Scio Rd.
(Approximate distance and direction from nearest city or town)

and is more particularly described as follows:
900 feet east of 400 feet south from NW corner Sect. 18,

(a) N.W. CORNER OF 80 ACRE TRACT, 32.86 CHAINS EAST OF S.W. CORNER OF PARTIEN WARE IN D.L.C. NO. 46.
(Give distance and bearing to corner of section or other legal subdivision)

being within NW 1/4 of NW 1/4 of Sec. 18, Twp. 10 S, Rge. 2 W
(Smallest legal subdivision) (N. or S.) (E. or W.)

or (b) within limits of recorded platted property, town or city:

in Lot _____, Block _____ of _____
(Name of plat or addition)

County of _____
(If within city or town, give name)

3. Construction Work was begun on JULY 1952; was completed on AUG. 1952
(Date) (Date)

and the ground water claimed was first used for the purposes set out below on AUG. 1952
(Date)

since which time the water has been used CONTINUOUSLY - INTERMITTENTLY DURING SEASON
(Continuously or intermittently)

from AUG. 1952 to AUG. 1958
(Date) (Date)

4. Quantity of water claimed and used is 84 gallons per minute; _____ acre feet per year.

5. Purpose or Purposes for which water is used DOMESTIC & IRRIGATION
(Domestic, irrigation, municipal, manufacturing, industrial, etc.)

6. Description of Well: Depth 21 feet. Type DRILLED
(Dug or drilled)

diameter 6 inches. Elevation of ground at well site 250 feet, mean sea level
(As near as known)

Depth to water table 14' - 16' feet.

7. Capacity of Well: _____ g.p.m. with _____ feet drawdown.

_____ g.p.m. with _____ feet drawdown.

Date of test _____

If Flowing Well: Measured discharge _____ g.p.m. on _____
(Date)

Shut-in pressure at ground surface _____ lbs. per sq. in. on _____
(Date)

Water is controlled by _____
(Cap, valve, etc.)

8. Casing: (Give diameter, commercial specifications and depth below ground surface of each casing size.)

6 inch diameter STEEL CASING from 0 to 21 feet
inch diameter from to feet
inch diameter from to feet
inch diameter from to feet

Describe and show depth of shoe, plug, adapter, liner or other details: _____

9. Perforated Casings or Screens:

yes from 15 to 21
(Number per foot and size of perforations, or describe screen)
from to
from to
from to

10. Log of Well: (Describe each stratum or formation clearly, indicate if water bearing, and give thickness and depth as indicated.)

MATERIAL	Thickness (Feet)	Depth to Bottom (Feet)
<u>sands & gravels</u>		

If log of well is not available, give name and address of driller. Fred Wymore

SALEM ORE

11. Infiltration Trench: Covered or open
 Dimensions: Length ft. Minimum depth ft. Maximum depth ft.
 Bottom width ft. Discharge g.p.m. Date of test

12. Tunnel: Type of lining
 Dimensions:
(Length, course, and cross sectional size)
 Position of water bearing stratum with reference to portal of tunnel

Log of tunnel: (Preceding table for log of well may be used, if desired. Give footage from portal and character of materials, as pertinent.)

13. Pumping Equipment:
 (a) Pump BERKLEY CENTRIFUGAL 2" x 2" Capacity 85 g.p.m.
(Make, type and size)
 (b) Motor G.E. 2 H.P. SINGLE PHASE
(Type and horsepower)


14. Location of area irrigated or to be irrigated, or place of use if for purposes other than irrigation.

Township North or South	Range E. or W. of Willamette Meridian	Section	Forty-acre Tract	Number Acres To Be Irrigated	Date of Reclamation
<u>10-SOUTH</u>	<u>2-WEST</u>	<u>SECT. 18</u>	<u>NW 1/4 of NW 1/4</u>	<u>2</u>	<u>1952</u>

15. If the ground water supply is supplemental to an existing water supply, identification of any application for a permit, permit, certificate or adjudicated right to appropriate water made or held by the registrant.

Township 10S Range 2W, W.M.

North

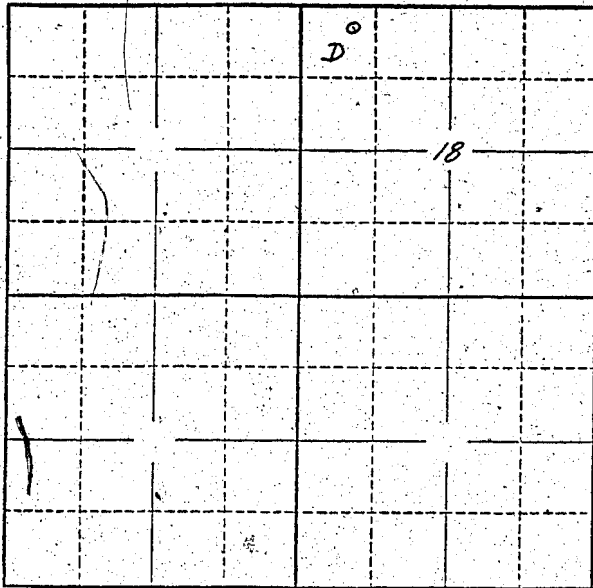

Locate well and acreage of irrigated land on plat.

Scale: 2" = 1 Mile

STATE OF OREGON

County of Marion } ss.

I, Leonard H. Marcum, being first duly sworn, do hereby certify that I have read the foregoing Registration Statement and that all of the items therein contained are true to the best of my knowledge and belief.

Leonard H. Marcum
(Signature of Registrant)

Subscribed and sworn to before me this 1st day of August, 1958

My commission expires 12th June 1961 Wm. S. Bartholomew
(Notary Public)

(SEAL)

CERTIFICATE OF REGISTRATION

STATE OF OREGON }
County of Marion } ss.

This is to certify that the foregoing Registration Statement was received in the office of the State Engineer on the 1st day of August, 1958, at 2:15 o'clock P.M. and has been duly recorded in said office in Book No. 14 of Registration Statements on page GR 3383

Witness my hand this 20th day of August, 1958

Luore A. Stanley
(State Engineer)

By _____
(Deputy)

GR 3383

#1500