Registration Statement

REGISTRATION NO. GR-3694

CERTIFICATE NO. GR-3384

OF CLAIMANT OF RIGHT TO APPROPRIATE GROUND WATER

(Under Chapter 708, Oregon Laws 1955.)

TO THE STATE ENGINEER OF OREGON:

I, Guy Wilcox Rt 1 Box 19 Hubbard oregon

of ..... County of Marion

State of Oregon, do hereby make application for a certificate of registration as evidence of a right to appropriate ground water.

1. **Source** from which water is withdrawn is pump well (Flowing well, pump well, infiltration trench, or tunnel)

2. **Location** is: 1/4 mile north of Hubbard (Approximate distance and direction from nearest city or town);

and is more particularly described as follows:

(a) 630' W & 530' N from S 1/4 corner Section 27 (Give distance and bearing to corner of section or other legal subdivision)

being within SE 1/4 SW 1/4 (Smallest legal subdivision) of Sec. 27, Twp. 4 S (N. or S.), Rge. 1 W (E. or W.)

or (b) within limits of recorded platted property, town or city: .....

in Lot ....., Block ..... of ..... (Name of plat or addition)

..... (If within city or town, give name) County of .....

3. **Construction Work** was begun on feb 1948 (Date); was completed on 1948 (Date)

and the ground water claimed was first used for the purposes set out below on 1949 (Date),

since which time the water has been used intermittent (Continuously or intermittently)

from June (Date) to September (Date).

4. **Quantity** of water claimed and used is 35 gallons per minute; ..... acre feet per year.

5. **Purpose or Purposes** for which water is used Girrigation

..... (Domestic, irrigation, municipal, manufacturing, industrial, etc.)

6. **Description of Well:** Depth 120 feet. Type drilled (Dug or drilled)

diameter 6 inches. Elevation of ground at well site ..... (As near as known) feet, mean sea level.

Depth to water table 20 feet.

7. **Capacity of Well:** 60 g.p.m. with little ~~feet~~ drawdown.

..... g.p.m. with ..... feet drawdown.

Date of test .....

If Flowing Well: Measured discharge ..... g.p.m. on ..... (Date)

Shut-in pressure at ground surface ..... lbs. per sq. in. on ..... (Date)

Water is controlled by ..... (Cap, valve, etc.)

8. **Casing:** (Give diameter, commercial specifications and depth below ground surface of each casing size.)

6 inch diameter Steel from 0 to 120 feet

..... inch diameter ..... from ..... to ..... feet

..... inch diameter ..... from ..... to ..... feet

..... inch diameter ..... from ..... to ..... feet

Describe and show depth of shoe, plug, adapter, liner or other details: .....

9. **Perforated Casings or Screens:**

Perforations from 80 to 120
(Number per foot and size of perforations, or describe screen)

..... from ..... to .....

..... from ..... to .....

..... from ..... to .....

10. **Log of Well:** (Describe each stratum or formation clearly, indicate if water bearing, and give thickness and depth as indicated.)

MATERIAL	Thickness (Feet)	Depth to Bottom (Feet)
not available		

GR 3384

If log of well is not available, give name and address of driller. .....

.....

11. **Infiltration Trench:** Covered or open .....

Dimensions: Length ..... ft. Minimum depth ..... ft. Maximum depth ..... ft.

Bottom width ..... ft. Discharge ..... g.p.m. Date of test .....

12. **Tunnel:** Type of lining .....

Dimensions: .....
(Length, course, and cross sectional size)

Position of water bearing stratum with reference to portal of tunnel .....

.....

Log of tunnel: (Preceding table for log of well may be used, if desired. Give footage from portal and character of materials, as pertinent.)

13. **Pumping Equipment:**

(a) Pump Turbine (Make, type and size) Capacity 35 g.p.m.

(b) Motor 3 hp (Type and horsepower)

14. Location of area irrigated or to be irrigated, or place of use if for purposes other than irrigation.

Township North or South	Range E. or W. of Willamette Meridian	Section	Forty-acre Tract	Number Acres To Be Irrigated	Date of Reclamation
4S	1W	27	SE¼ SW¼	8	1949
"	"	"	SW¼ SE¼	1	"
4S	1W	34	NE¼ NW¼	½	"
"	"	"	NW¼ NE¼	½	"
				Total 10 ac	"

15. If the ground water supply is supplemental to an existing water supply, identification of any application for a permit, permit, certificate or adjudicated right to appropriate water made or held by the registrant.

.....

.....

Township 4S Range 1W, W.M.

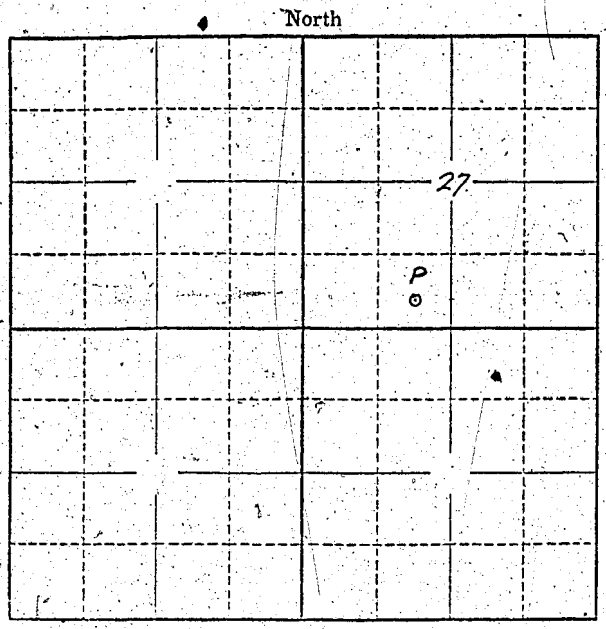

Locate well and acreage of irrigated land on plat.

Scale: 2" = 1 Mile

STATE OF OREGON
County of Marion } ss.

I, Guy Wilcox, being first duly sworn, do hereby certify that I have read the foregoing Registration Statement and that all of the items therein contained are true to the best of my knowledge and belief.

Guy Wilcox
(Signature of Registrant)

Subscribed and sworn to before me this 1st day of August, 1958.

My commission expires 12th June 1961

Wm. S. Bartholomew
(Notary Public)

(SEAL)

CERTIFICATE OF REGISTRATION

STATE OF OREGON
County of Marion } ss.

This is to certify that the foregoing Registration Statement was received in the office of the State Engineer on the 1 day of August, 1958, at 2:10 o'clock P M. and has been duly recorded in said office in Book No. 14 of Registration Statements on page GR-3384

xx ~~Construction shall be completed by xxxxxxxxxxxxxxxxxxxx 19xx and the water completely applied to beneficial use by xxxxxxxxxxxxxxxxxxxx 19xx~~ xx

Witness my hand this 20th day of August, 1950.

Lewis A. Stanley
(State Engineer)

$15.00

By
(Deputy)

GR-3384