

# Registration Statement

## OF CLAIMANT OF RIGHT TO APPROPRIATE GROUND WATER

### TO THE STATE ENGINEER OF OREGON:

I, W. Guy Parker, Secretary, Muddy River Hunt Club, Inc.,  
of 215 Monroe St., Corvallis County of Benton,  
(Mailing address)  
State of Oregon, do hereby make application for a certificate of registration as evidence of a right to appropriate ground water.

1. Source from which water is withdrawn is pump well  
(Flowing well, pump well, infiltration trench, or tunnel)

2. Location is: eleven and one half miles south-west of Corvallis, Ore.  
(Approximate distance and direction from nearest city or town)

and is more particularly described as follows:

(a) 1025 feet east & 210 feet north from W 1/4 corner  
(Give distance and bearing to corner of section or other legal subdivision)

being within SW 1/4 of NW 1/4 of Sec. 21, Twp. 13S Rge. 5W  
(Smallest legal subdivision) (N. or S.) (E. or W.)

or (b) within limits of recorded platted property, town or city:

in Lot \_\_\_\_\_ Block \_\_\_\_\_ of \_\_\_\_\_  
(Name of plat or addition)  
County of Benton,  
(If within city or town, give name)

3. Construction Work was begun on No information; was completed on No information  
(Date) (Date)  
and the ground water claimed was first used for the purposes set out below on about 1935  
(Date)  
since which time the water has been used continuously  
(Continuously or intermittently)  
from 1935 to 1958  
(Date) (Date)

4. Quantity of water claimed and used is Not known gallons per minute; not known acre feet per year.

5. Purpose or Purposes for which water is used domestic, stock and irrigation  
(Domestic, irrigation, municipal, manufacturing, industrial, etc.)

6. Description of Well: Depth Not known feet. Type Not known Driven  
(Dug or drilled)  
diameter 1 1/2 inch at the top. Elevation of ground at well site 300ft. feet, mean sea level.  
(As near as known)  
Depth to water table Not known feet.

7. Capacity of Well: Not known g.p.m. with Not known feet drawdown.  
\_\_\_\_\_ g.p.m. with \_\_\_\_\_ feet drawdown.

Date of test None

If Flowing Well: Measured discharge \_\_\_\_\_ g.p.m. on \_\_\_\_\_  
(Date)


Shut-in pressure at ground surface \_\_\_\_\_ lbs. per sq. in. on \_\_\_\_\_  
(Date)

Water is controlled by \_\_\_\_\_  
(Cap, valve, etc.)





Township 13N Range 5W, W.M.  
North

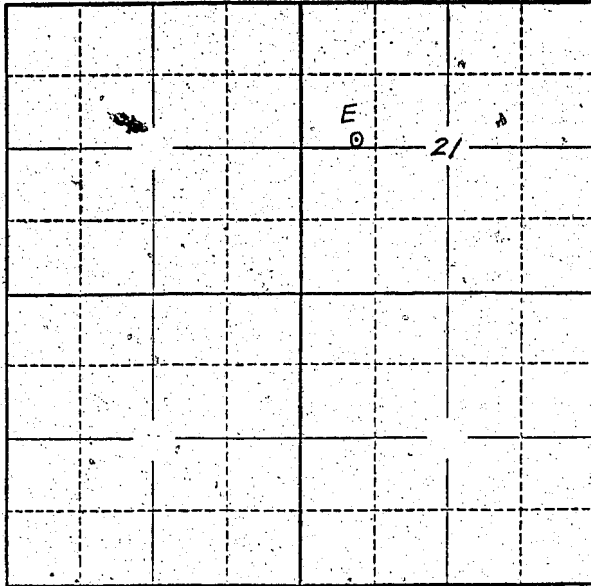

Locate well and acreage of irrigated land on plat.  
Scale: 2" = 1 Mile

STATE OF OREGON

County of Benton, } ss.

I, W. Guy Parker, being first duly sworn, do hereby certify that I have read the foregoing Registration Statement and that all of the items therein contained are true to the best of my knowledge and belief.

*W. Guy Parker*  
\_\_\_\_\_  
(Signature of Registrant)

Subscribed and sworn to before me this 30th day of July, 1958.

My commission expires 7/16/60

*W. Guy Parker*  
\_\_\_\_\_  
(Notary Public)

(SEAL)

**CERTIFICATE OF REGISTRATION**

STATE OF OREGON

County of Marion } ss.

This is to certify that the foregoing Registration Statement was received in the office of the State Engineer on the 1 day of August, 1958, at 8:00 o'clock A.M. and has been duly recorded in said office in Book No. 14 of Registration Statements on page GR 3386

Witness my hand this 20th day of August, 1959

*Lewis A. Stanley*  
\_\_\_\_\_  
(State Engineer)

By \_\_\_\_\_  
(Deputy)

GR 3386

\$15.00