

Registration Statement

OF CLAIMANT OF RIGHT TO APPROPRIATE GROUND WATER

TO THE STATE ENGINEER OF OREGON:

I, Robert Nelson

of Hubbard Box 259 County of Marion

State of Oregon, do hereby make application for a certificate of registration as evidence of a right to appropriate ground water.

1. Source from which water is withdrawn is Pump well
(Flowing well, pump well, infiltration trench, or tunnel)

2. Location is: Approximately 1 mile east of Hubbard
(Approximate distance and direction from nearest city or town)

and is more particularly described as follows:

(a) 700 ft. m/l east and 40 ft. south of south 1/4 cor. of Sec 34
(Give distance and bearing to corner of section or other legal subdivision)

being within S 1/4 NW 1/4 NW 1/4 of Sec. 34, Twp. S 5 N 5, Rge. 1 W
(Smallest legal subdivision) (N. or S.) (E. or W.)

or (b) within limits of recorded platted property, town or city:

in Lot _____, Block _____ of _____
(Name of plat or addition)

County of _____
(If within city or town, give name)

3. Construction Work was begun on 8/12/54; was completed on 8/18/54
(Date) (Date)

and the ground water claimed was first used for the purposes set out below on June 1953 for irrigation and on 8/25/54 for domestic use.
(Date)

since which time the water has been used continuously
(Continuously or intermittently)

from 1954 to 1958
(Date) (Date)

4. Quantity of water claimed and used is 30 gallons per minute; 3 acre feet per year.

5. Purpose or Purposes for which water is used Irrigation
(Domestic, irrigation, municipal, manufacturing, industrial, etc.)

6. Description of Well: Depth 101 feet. Type Drilled
(Dug or drilled)

diameter 8 inches. Elevation of ground at well site 140 ± feet, mean sea level.
(As near as known)

Depth to water table 23 feet.

7. Capacity of Well: 200 g.p.m. with 50 feet drawdown.

_____ g.p.m. with _____ feet drawdown.

Date of test 8/18/54

If Flowing Well: Measured discharge _____ g.p.m. on _____
(Date)

Shut-in pressure at ground surface _____ lbs. per sq. in. on _____
(Date)

Water is controlled by _____
(Cap, valve, etc.)

8. Casing: (Give diameter, commercial specifications and depth below ground surface of each casing size.)

8 inch diameter from 0 to 100 feet
 inch diameter from to feet
 inch diameter
 inch diameter

Describe and show depth of shoe, plug, adapter, liner or other details:

9. Perforated Casings or Screens:

from to
 (Number per foot and size of perforations, or describe screen)
 from to
 from to
 from to

10. Log of Well: (Describe each stratum or formation clearly, indicate if water bearing, and give thickness and depth as indicated.)

MATERIAL	Thickness (Feet)	Depth to Bottom (Feet)
Surface	0	3
Brown Sandy clay	3	24
Gray Sand	24	40
Brown Clay	40	48
Gray clay	48	86
Blue clay	86	99
Coarse Sand	99	101

If log of well is not available, give name and address of driller:

11. Infiltration Trench: Covered or open

Dimensions: Length ft. Minimum depth ft. Maximum depth ft.

Bottom width ft. Discharge g.p.m. Date of test

12. Tunnel: Type of lining

Dimensions:
(Length, course, and cross sectional size)

Position of water bearing stratum with reference to portal of tunnel

Log of tunnel: (Preceding table for log of well may be used, if desired. Give footage from portal and character of materials, as pertinent.)

13. Pumping Equipment:

(a) Pump *Farrbanks Morse - turbine* Capacity g.p.m.
(Make, type and size)

(b) Motor *5 H.P. G.E.*
(Type and horsepower)


14. Location of area irrigated or to be irrigated, or place of use if for purposes other than irrigation.

Township North or South	Range E. or W. of Willamette Meridian	Section	Forty-acre Tract	Number Acres To Be Irrigated	Date of Reclamation
<i>4 S</i>	<i>1 W</i>	<i>34</i>	<i>SW 1/4 SE 1/4</i>	<i>3.5</i>	<i>6/1/55</i>
<i>5 S</i>	<i>1 W</i>	<i>3</i>	<i>NW 1/4 NE 1/4</i>	<i>1.5</i>	<i>6/1/55</i>
				<i>5.0 Ac</i>	

15. If the ground water supply is supplemental to an existing water supply, identification of any application for a permit, permit, certificate or adjudicated right to appropriate water made or held by the registrant.

Township 55 Range 1W, W.M.

North

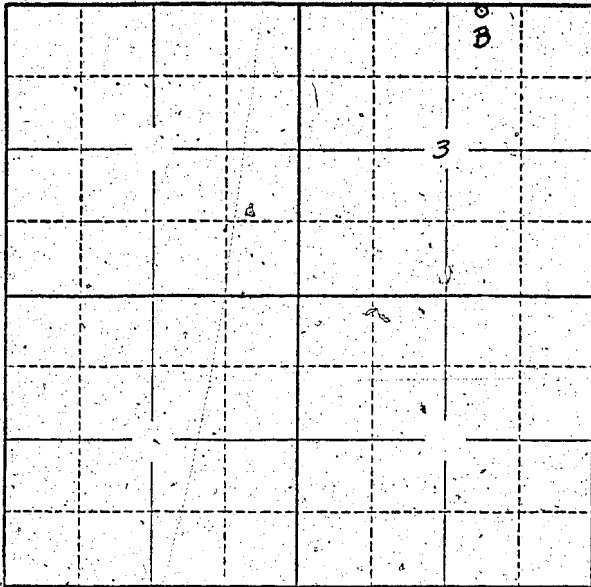

Locate well and acreage of irrigated land on plat.

Scale: 2" -- 1 Mile

STATE OF OREGON

County of Marion } ss.

I, Robert Nelson, being first duly sworn, do hereby certify that I have read the foregoing Registration Statement and that all of the items therein contained are true to the best of my knowledge and belief.

Robert Nelson
(Signature of Registrant)

Subscribed and sworn to before me this 1st day of August, 1958

My commission expires 12th June 1961 Wm. S. Bartholomew
(Notary Public)

(SEAL)

CERTIFICATE OF REGISTRATION

STATE OF OREGON

County of Marion } ss.

This is to certify that the foregoing Registration Statement was received in the office of the State Engineer on the 1st day of August, 1958, at 2:30 o'clock P. M. and has been duly recorded in said office in Book No. 14 of Registration Statements on page GR 3387

Witness my hand this 20th day of August, 1959

Lewis A. Stanley
(State Engineer)

By _____ (Deputy)

GR. 3387

\$15.00