

RECEIVED
NOV 14 1955
STATE ENGINEER
SALEM, OREGON

REGISTRATION NO. GR-37
CERTIFICATE NO. GR-32

Registration Statement

OF CLAIMANT OF RIGHT TO APPROPRIATE GROUND WATER

(Under Chapter 708, Oregon Laws 1955.)

TO THE STATE ENGINEER OF OREGON:

I, J. L. McFarland
of Rt. 1, Tangent County of Linn

State of Oregon, do hereby make application for a certificate of registration as evidence of a right to appropriate ground water.

1. Source from which water is withdrawn is pump well
(Flowing well, pump well, infiltration trench, or tunnel)

2. Location is: 2 miles north of Tangent
(Approximate distance and direction from nearest city or town)

and is more particularly described as follows:

(a) S. 83° E. 14.5 chains from the NE corner of the Adam Settlement D.L.C. 65
(Give distance and bearing to corner of section or other legal subdivision)

being within NE 1/4 of SW 1/4 of Sec. 31, Twp. 11 S, Rge. 3 W
(Smallest legal subdivision) (N. or S.) (E. or W.)

or (b) within limits of recorded platted property, town or city:

in Lot _____, Block _____ of _____
(Name of plat or addition)

County of Linn
(If within city or town, give name)

3. Construction Work was begun on July 10, 1936; was completed on July 13, 1936
(Date) (Date)

and the ground water claimed was first used for the purposes set out below on Sept. 10, 1936
(Date)

since which time the water has been used continuously
(Continuously or intermittently)

from Sept. 10, 1936 to Oct. 1, 1955
(Date) (Date)

4. Quantity of water claimed and used is 120 gallons per minute; 70 acre feet per year.

5. Purpose or Purposes for which water is used: Irrigation and to fill small pond for stock water.
(Domestic, irrigation, municipal, manufacturing, industrial, etc.)

6. Description of Well: Depth 42 feet. Type Drilled
(Dug or drilled)

diameter 8 inches. Elevation of ground at well site 235 feet, mean sea level.
(As near as known)

Depth to water table 14 feet.

7. Capacity of Well: 150 g.p.m. with 28 feet drawdown.
_____ g.p.m. with _____ feet drawdown.

Date of test Sept. 10, 1954

If Flowing Well: Measured discharge _____ g.p.m. on _____
(Date)

Shut-in pressure at ground surface _____ lbs. per sq. in. on _____
(Date)

Water is controlled by _____
(Cap, valve, etc.)

11. Infiltration Trench: Covered or open

Dimensions: Length ft. Minimum depth ft. Maximum depth ft.

Bottom width ft. Discharge g.p.m. Date of test

12. Tunnel: Type of lining

Dimensions:
(Length, course, and cross sectional size)

Position of water bearing stratum with reference to portal of tunnel

Log of tunnel: (Preceding table for log of well may be used, if desired. Give footage from portal and character of materials, as pertinent.)

13. Pumping Equipment:

(a) Pump Gould 1 1/2" centrifugal pump Capacity 120 g.p.m.
(Make, type and size)

(b) Motor 5 H.P. electric motor
(Type and horsepower)

14. Location of area irrigated or to be irrigated, or place of use if for purposes other than irrigation.

Township North or South	Range E. or W. of Willamette Meridian	Section	Forty-acre Tract	Number Acres To Be Irrigated	Date of Reclamation
11 S	3 W	31	SW 1/4 of NE 1/4	3.6	prior to 1936
11 S	3 W	31	SE 1/4 of NW 1/4	11.1	" " "
11 S	3 W	31	NE 1/4 of SW 1/4	31.0	" " "
11 S	3 W	31	NW 1/4 of SE 1/4	7.0	" " "
				52.7	

McFarland


127-143

The South half of the D.L.C. of Reuban McFarland Not. # 1936 in Sec. 31, T. 11 S., R 3 W. of the Will. Mer. in Linn County, Oregon; containing 159.21 acres, more or less all lying and being situated in Linn County, Oregon: Beginning at a point on the West boundary line of the D.L.C. of Reuban McFarland No. 1936 in T. 11 S., R 3 W. of the Will. Mer 125 feet North of the intersection ~~with~~ the North boundary line of the D.L.C. of Adam Settlemire Not #. 1818 Claim #65 in said Township and Range aforesaid and running thence West on a line parallel with the North boundary line of the D.L.C. of Adam Settlemire to the center of the right-of-way of the Oregon & California (now Southern Pacific Railway Co.) ; thence North along the center of said right-of-way 25 feet; thence East on a line parallel with the North boundary line of the D.L.C. of Adam Settlemire to the West boundary line of the D.L.C. of Reuben McFarland; thence South 25 feet to the place of beginning also the following.

Beginning at a point in the center of the right-of-way of the Ore & Calif. (now Southern Pacific Railroad Co. 150 feet North of the North boundary line of the D.L.C. of Adam Settlemire aforesaid and running thence West parallel with the North boundary line of said D.L.C. to the East boundary line of the Pacific Highway; thence South along the East boundary line of the Pacific Highway 25 feet; thence East parallel with the North boundary line of the D.L.C. of Adam Settlemire to the center of the right-of-way of the aforesaid railroad; thence North 25 feet to the place of beginning.

15. If the ground water supply is supplemental to an existing water supply, identification of any application for a permit, permit, certificate or adjudicated right to appropriate water made or held by the registrant.

Township 11s Range 3w W.M.
North

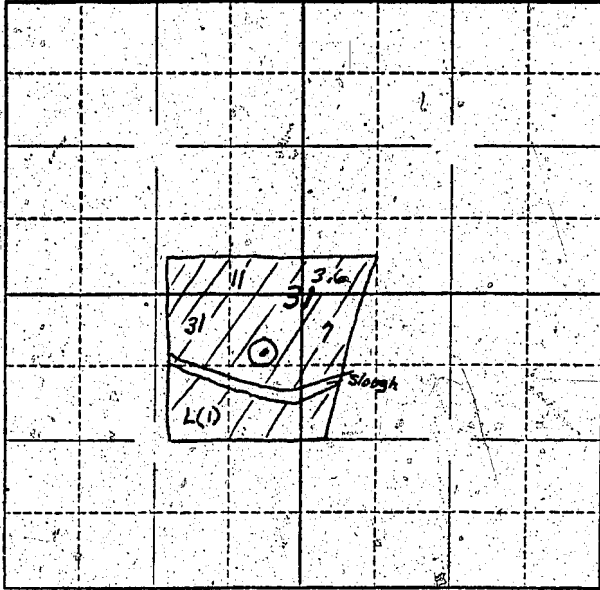

Locate well and acreage of irrigated land on plat.

Scale: $\frac{1}{4}$ " = 1 Mile

STATE OF OREGON
County of Linn } ss.

I, J. L. McFarland, being first duly sworn, do hereby certify that I have read the foregoing Registration Statement and that all of the items therein contained are true to the best of my knowledge and belief.

J. L. McFarland
(Signature of Registrant)

Subscribed and sworn to before me this 10th day of November, 1955.

My commission expires _____
R. M. Russell
County Clerk

(SEAL)

CERTIFICATE OF REGISTRATION

STATE OF OREGON
County of Marion } ss.

This is to certify that the foregoing Registration Statement was received in the office of the State Engineer on the 14th day of November, 1955, at 9:00 o'clock A.M. and has been duly recorded in said office in Book No. 1 of Registration Statements on page 32.

Construction shall be completed by _____, 1955, and the water, completely applied to beneficial use by _____, 1955.

Witness my hand this 24th day of February, 1956.
Lewis A. Strubley
(State Engineer)

By _____
(Deputy)