

RECEIVED

FEB 14 1957
STATE ENGINEER
SALEM, OREGON

REGISTRATION NO. GR-370

Registration Statement CERTIFICATE NO. GR 356

OF CLAIMANT OF RIGHT TO APPROPRIATE GROUND WATER

(Under Chapter 708, Oregon Laws 1955.)

TO THE STATE ENGINEER OF OREGON:

I, Kenneth W. Cearley
of 3649 Biddle Road, Medford County of Jackson

State of Oregon, do hereby make application for a certificate of registration as evidence of a right to appropriate ground water.

1. Source from which water is withdrawn is Sump
(Flowing well, pump well, infiltration trench, or tunnel)

2. Location is: Approximately 2 miles north of Medford, Oregon
(Approximate distance and direction from nearest city or town)

and is more particularly described as follows:

(a) S. 40° 24' W. 1008 feet from the EA corner of section 12
(Give distance and bearing to corner of section or other legal subdivision)

being within NE 1/4 Sec 12 of Sec. 12, Twp. 37S, Rge. 2W
(Smallest legal subdivision) (N. or S.) (E. or W.)

or (b) within limits of recorded platted property, town or city:

in Lot _____, Block _____ of _____
(Name of plat or addition)

County of _____
(If within city or town, give name)

3. Construction Work was begun on August 1950; was completed on August 1956
(Date) (Date)

and the ground water claimed was first used for the purposes set out below on August 1950
(Date)

since which time the water has been used Continuously
(Continuously or intermittently)

from August 1950 to February 1957
(Date) (Date)

4. Quantity of water claimed and used is 108 gallons per minute; 4.5 acre feet per year.

5. Purpose or Purposes for which water is used: Irrigation

(Domestic, irrigation, municipal, manufacturing, industrial, etc.)

6. Description of Well: Depth 18 feet. Type DUG
(Dug or drilled)

diameter 6 1/2 inches. Elevation of ground at well site 1300 feet, mean sea level.
(As near as known)

Depth to water table 10 feet. Note: See Item 11

7. Capacity of Well: _____ g.p.m. with _____ feet drawdown.

_____ g.p.m. with _____ feet drawdown.

Date of test _____

If Flowing Well: Measured discharge _____ g.p.m. on _____
(Date)

Shut-in pressure at ground surface _____ lbs. per sq. in. on _____
(Date)

Water is controlled by _____
(Cap, valve, etc.)

8. Casing: (Give diameter, commercial specifications and depth below ground surface of each casing size.)

..... inch diameter from to feet
 inch diameter from to feet
 inch diameter from to feet
 inch diameter from to feet

Describe and show depth of shoe, plug, adapter, liner or other details:

.....

.....

9. Perforated Casings or Screens:

..... from to

(Number per foot and size of perforations, or describe screen)

..... from to

..... from to

..... from to

10. Log of Well: (Describe each stratum or formation clearly, indicate if water bearing, and give thickness and depth as indicated.)

MATERIAL	Thickness (Feet)	Depth to Bottom (Feet)

If log of well is not available, give name and address of driller.....

11. Infiltration Trench: Covered or open Open

Dimensions: Length 54 ft. Minimum depth 18 ft. Maximum depth 18 ft.

Bottom width 16 ft. Discharge not known g.p.m. Date of test none

12. Tunnel: Type of lining.....

Dimensions:.....
(Length, course, and cross sectional size)

Position of water bearing stratum with reference to portal of tunnel.....

Log of tunnel: (Preceding table for log of well may be used, if desired. Give footage from portal and character of materials, as pertinent.)

13. Pumping Equipment:

(a) Pump 4 in. pump on 32 hp gasoline engine Capacity 600 (est.) g.p.m.
(Make, type and size)

(b) Motor.....
(Type and horsepower)


14. Location of area irrigated or to be irrigated, or place of use if for purposes other than irrigation.

Township North or South	Range E. or W. of Wilmansette Meridian	Section	Four-acre Tract	Number Acres To Be Irrigated	Date of Reclamation
37S	2W	12	NE 1/4 of SE 1	3.5 acres	Aug. 1950
37S	2W	12	NW 1/4 of SE 1	6.0 acres	Aug. 1950
				<u>9.5</u>	

15. If the ground water supply is supplemental to an existing water supply, identification of any application for a permit, permit, certificate or adjudicated right to appropriate water made or held by the registrant

None

Township 37S Range 2W W.M.
North

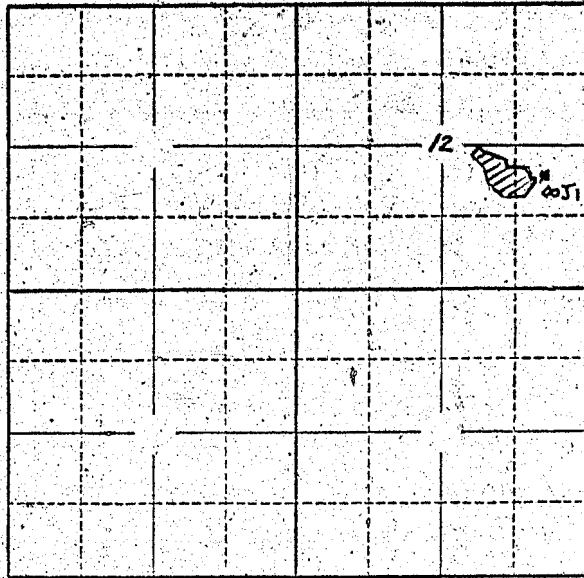

Locate well and acreage of irrigated land on plat.
Scale: 2" = 1 Mile

STATE OF OREGON

County of Jackson } ss.

I, Kenneth Cearley, being first duly sworn, do hereby certify that I have read the foregoing Registration Statement and that all of the items therein contained are true to the best of my knowledge and belief.

Kenneth Cearley
(Signature of Registrant)

Subscribed and sworn to before me this 13th day of February, 19 57

My commission expires August 10 1957

Earl O. ...
(Notary Public)

(SEAL)

CERTIFICATE OF REGISTRATION

STATE OF OREGON }
County of Marion } ss.

This is to certify that the foregoing Registration Statement was received in the office of the State Engineer on the 11th day of February, 19 57, at 8:00 o'clock A.M. and has been duly recorded in said office in Book No. 2 of Registration Statements on page GR-356 C.

~~Construction work to be completed by X-X-X-X-X-X-X-X-X-X and the water completely applied to beneficial use by X-X-X-X-X-X-X-X-X-X~~

Witness my hand this 30th day of April, 19 57

Lewis A. Stanley
(State Engineer)

\$15.00

By _____
(Deputy)