

Registration Statement

OF CLAIMANT OF RIGHT TO APPROPRIATE GROUND WATER

TO THE STATE ENGINEER OF OREGON:

I, Russel L. Hicks
 of Pt 1 Rgy 455 - Salem County of Polk
(Mailing address)

State of Oregon, do hereby make application for a certificate of registration as evidence of a right to appropriate ground water.

1. Source from which water is withdrawn is Pump well
(Flowing well, pump well, infiltration trench, or tunnel)

2. Location is: 8 mi. NW Salem - Wallace Rd
(Approximate distance and direction from nearest city or town)

and is more particularly described as follows:

(a) 950' N x 550' W from SW corner Section 19
(Give distance and bearing to corner of section or other legal subdivision)

being within SE 1/4 SW 1/4 of Sec. 19, Twp. 6S, Rge. 3W
(Smallest legal subdivision) (N. or S.) (E. or W.)

or (b) within limits of recorded platted property, town or city;

in Lot , Block of
(Name of plat or addition)

 County of
(If within city or town, give name)

3. Construction Work was begun on 4-Feb-1953; was completed on May 1953
(Date) (Date)

and the ground water claimed was first used for the purposes set out below on May 1953
(Date)

since which time the water has been used Continuously Yearly
(Continuously or intermittently)

from May 15 to Sept 15
(Date) (Date)

4. Quantity of water claimed and used is 200 gallons per minute; acre feet per year.

5. Purpose or Purposes for which water is used IRRIGATION
(Domestic, irrigation, municipal, manufacturing, industrial, etc.)

6. Description of Well: Depth 90 feet. Type, Drilled
(Dug or drilled)

diameter 8 inches. Elevation of ground at well site feet, mean sea level.
(As near as known)

Depth to water table 20 feet.

7. Capacity of Well: 240 g.p.m. with 80 feet drawdown.

200 g.p.m. with feet drawdown.

Date of test May 1953

If Flowing Well: Measured discharge g.p.m. on
(Date)

Shut-in pressure at ground surface lbs. per sq. in. on
(Date)

Water is controlled by
(Cap, valve, etc.)

.....

(Number per foot and size of perforations, or describe screen)	from	to
	from	to
	from	to
	from	to

[illegible]

If log of well is not available, give name and address of driller. Fl. Wilcox - Minnerville

11. Infiltration Trench: Covered or open

Dimensions: Length ft. Minimum depth ft. Maximum depth ft.

Bottom width ft. Discharge g.p.m. Date of test

12. Tunnel: Type of lining

Dimensions:
(Length, course, and cross sectional size)

Position of water bearing stratum with reference to portal of tunnel

Log of tunnel: (Preceding table for log of well may be used, if desired. Give footage from portal and character of materials, as pertinent.)

13. Pumping Equipment:

(a) Pump Bentley 10 HP turbine Capacity 200 g.p.m.
(Make, type and size)

(b) Motor Gen. Electric 10 HP
(Type and horsepower)

14. Location of area irrigated or to be irrigated, or place of use if for purposes other than irrigation.

Township North or South	Range E. or W. of Willamette Meridian	Section	Forty-acre Tract	Number Acres To Be Irrigated	Date of Reclamation
<u>6</u>	<u>3 W</u>	<u>19</u>	<u>SE 1/4 - SW 1/4</u>	<u>3 1/4</u> 25	<u>1953</u>
<u>6</u>	<u>3 W</u>	<u>19</u>	<u>SW 1/4 - SW 1/4</u>	<u>4</u> 5	<u>"</u>
<u>6</u>	<u>3 W</u>	<u>30</u>	<u>NW 1/4 NW 1/4</u>	<u>2</u> 3	<u>"</u>
<u>6</u>	<u>3 W</u>	<u>30</u>	<u>NE 1/4 NW 1/4</u>	<u>14</u> 25	<u>"</u>
				<u>Total 58 1/2</u>	<u>"</u>

Beginning at a point 38.05 chains North from the Southwest corner of the D.L.C. of Wellington B. Walker and wife, Not. No. 150, Claim No. 49 in Township 6 South, Range 3 West of the Willamette Meridian, Polk County, Oregon; thence North along the West line of said Claim 55.50 chains to the Northwest corner of said Claim; thence East following the North line of said Claim 27.03 chains; thence South parallel with the West line of said Claim, 55.50 chains; thence West 27.03 chains to the place of beginning and being the same premises conveyed by A. J. Purvine and Pauline Purvine, his wife, to Jordan Purvine by deed dated December 8, 1886 and recorded December 22, 1886 in Volume 17 Page 377, Polk County, Deed Records.


SUBJECT TO: Easement dated June 12, 1940 and recorded June 21, 1940 in Volume 106 at page 107 of the Deed Records of Polk County, Oregon.

15. If the ground water supply is supplemental to an existing water supply, identification of any application for a permit, permit, certificate or adjudicated right to appropriate water made or held by the registrant.

None

S $\frac{1}{2}$ Section 19 & N $\frac{1}{2}$ Sect 30

Township 6S Range 3W, W.M.

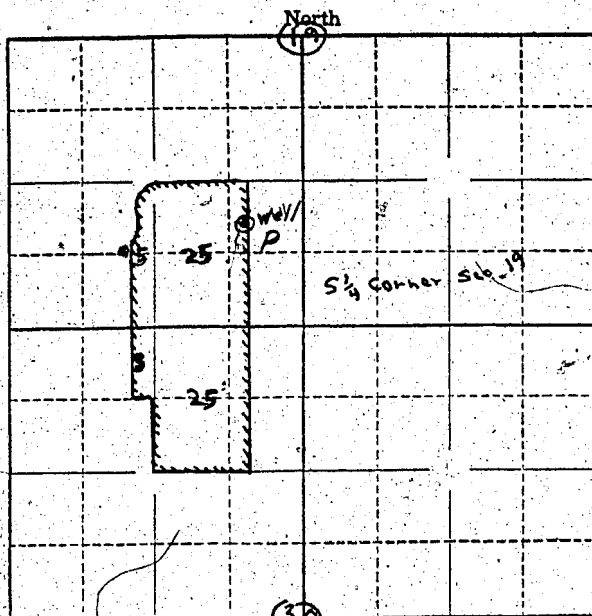

Locate well and acreage of irrigated land on plat.

Scale: 2" = 1 Mile

STATE OF OREGON

County of

Russell L. Hicks

I, Russell L. Hicks, being first duly sworn, do hereby certify that I have read the foregoing Registration Statement and that all of the items therein contained are true to the best of my knowledge and belief.

Russell L. Hicks
(Signature of Registrant)

Subscribed and sworn to before me this 1st day of August, 1958

My commission expires 12th June 1961

Wm. S. Bartholomew
(Notary Public)

(SEAL)

CERTIFICATE OF REGISTRATION

STATE OF OREGON

County of Marion

ss.

This is to certify that the foregoing Registration Statement was received in the office of the State Engineer on the 1st day of August, 1958, at 8:00 o'clock A. M. and has been duly recorded in said office in Book No. 14 of Registration Statements on page GR-3388

Witness my hand this 20th day of August, 1959

Lawrence A. Stanley
(State Engineer)

By

(Deputy)

GR 3388