

Registration Statement

OF CLAIMANT OF RIGHT TO APPROPRIATE GROUND WATER

TO THE STATE ENGINEER OF OREGON

I, Kernville-Gleneden Beach-Lincoln Beach Water District

of Box 96, Gleneden Beach County of Lincoln

(Mailing address)

State of Oregon do hereby make application for a certificate of registration as evidence of a right to appropriate ground water.

1. Source from which water is withdrawn is well
(Flowing well, pump well, infiltration trench, or tunnel)

2. Location is: one mile North of Lincoln Beach, Oregon
(Approximate distance and direction from nearest city or town)

and is more particularly described as follows:

(a) Approximately 2670 feet West and 30 feet South of NE Corner of Section 20,
(Give distance and bearing to corner of section or other legal subdivision)

being within Box 96 of Sec. 23, Twp. 8 S, Rge. 11 W,
(Smallest legal subdivision) (N. or S.) (E. or W.)

or (b) within limits of recorded platted property, town or city:

in Lot _____ Block _____ of _____
(Name of plat or addition)

(If within city or town, give name)

County of _____

3. Construction Work was begun on July, 1955 was completed on 1955
(Date) (Date)

and the ground water claimed was first used for the purposes set out below on 1955
(Date)

since which time the water has been used continuously
(Continuously or intermittently)

from 1955 to 1958
(Date) (Date)

4. Quantity of water claimed and used is 4450 lcf gallons per minute; _____ acre feet per year.

5. Purpose or Purposes for which water is used (domestic - municipal) > 15,000 gpd.

(Domestic, irrigation, municipal, manufacturing, industrial, etc.)

6. Description of Well: Depth 107 feet. Type drilled
(Dug or drilled)

diameter 10 inches. Elevation of ground at well site _____ feet, mean sea level.

(As near as known)

Depth to water table 60 feet.

7. Capacity of Well: _____ g.p.m. with _____ feet drawdown.

_____ g.p.m. with _____ feet drawdown.

Date of test _____

If Flowing Well: Measured discharge _____ g.p.m. on _____
(Date)

Shut-in pressure at ground surface _____ lbs. per sq. in. on _____
(Date)

Water is controlled by _____
(Cap. valve, etc.)

8. Casing: (Give diameter, commercial specifications and depth below ground surface of each casing size.)

..... inch diameter from to feet
 inch diameter from to feet
 inch diameter from to feet
 inch diameter from to feet

Describe and show depth of shoe, plug, adapter, liner or other details:

9. Perforated Casings or Screens:

(Number per foot and size of perforations, or describe screen) from to
 from to
 from to
 from to

10. Log of Well: (Describe each stratum or formation clearly, indicate if water bearing, and give thickness and depth as indicated.)

MATERIAL	Thickness (Feet)	Depth to Bottom (Feet)

✓ If log of well is not available, give name and address of driller.

11. Infiltration Trench: Covered or open

Dimensions: Length ft. Minimum depth ft. Maximum depth ft.

Bottom width ft. Discharge g.p.m. Date of test

12. Tunnel: Type of lining

Dimensions:
(Length, course, and cross sectional size)

Position of water bearing stratum with reference to portal of tunnel

Log of tunnel: (Preceding table for log of well may be used, if desired. Give footage from portal and character of materials, as pertinent.)

13. Pumping Equipment:

(a) Pump Jacouzzi Capacity 450 g.p.m.
(Make, type and size)


(b) Motor 15 h.p.
(Type and horsepower)

14. Location of area irrigated or to be irrigated, or place of use if for purposes other than irrigation.

Township North or South	Range E. or W. of Willamette Meridian	Section	Forty-acre Tract	Number Acres To Be Irrigated	Date of Reclamation
<u>T8S</u>	<u>R11W</u>	<u>28</u>	<u>NE¹/₄ of NW¹/₄</u>	<u>Municipal uses</u>	<u>1955</u>

15. If the ground water supply is supplemental to an existing water supply, identification of any application for a permit, permit, certificate or adjudicated right to appropriate water made or held by the registrant.

Township T8S Range 11W, W.M.
North

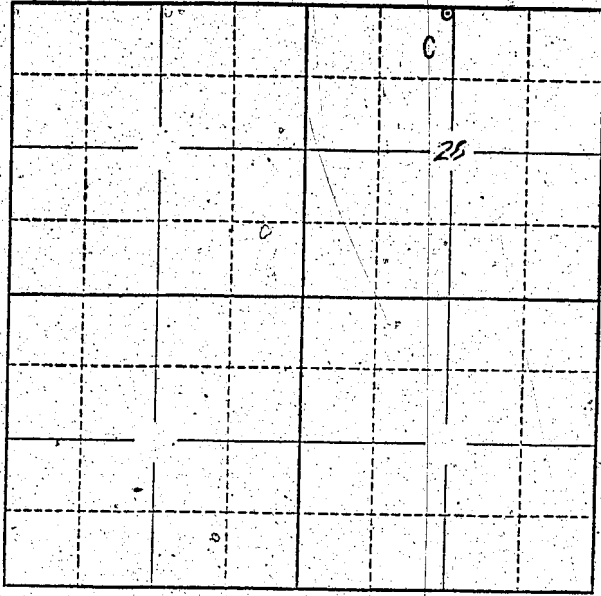

Locate well and acreage of irrigated land on plat.
Scale: 2" = 1 Mile

STATE OF OREGON

County of Lincoln } ss.

Attorney for the Kernville-Gleneden Beach-Lincoln Beach Water District,
I, Raymond G. Wood, being first duly sworn, do hereby certify that I have
read the foregoing Registration Statement and that all of the items therein contained are true to the best of
my knowledge and belief.

Raymond G. Wood
(Signature of Registrant)

Subscribed and sworn to before me this 1st day of August, 1958.

My commission expires July 29, 1960.

Laura M. Wood
(Notary Public) for Oregon

(SEAL)

CERTIFICATE OF REGISTRATION

STATE OF OREGON } ss.
County of Marion

This is to certify that the foregoing Registration Statement was received in the office of the State
Engineer on the 1 day of August, 1958, at 2:57 o'clock P.M. and has been
duly recorded in said office in Book No. 16 of Registration Statements on page GR-3913

Witness my hand this 15th day of February, 1960

Laura A. Stanley
(State Engineer)

By _____ (Deputy)

GR 3913

20.00