

RECEIVED
AUG 1 1958
STATE ENGINEER
SALMON WILSON
RECEIVED
JAN 26 1960
STATE ENGINEER
SALMON WILSON

REGISTRATION NO. GR-3704
CERTIFICATE NO. GR-3951

Registration Statement

OF CLAIMANT OF RIGHT TO APPROPRIATE GROUND WATER

(Under Chapter 708, Oregon Laws 1955.)

TO THE STATE ENGINEER OF OREGON:

I, Bernice Wilkins,

of Idaville, Day City County of Tillamook

State of Oregon, do hereby make application for a certificate of registration as evidence of a right to appropriate ground water.

1. Source from which water is withdrawn is pump well
(Flowing well, pump well, infiltration trench, or tunnel)

2. Location is: 4 miles northwest of Tillamook City Oregon
(Approximate distance and direction from nearest city or town)

and is more particularly described as follows:

(a) 650 feet south of 1100 feet west from NE corner Section 11 T15, R10W,
(Give distance and bearing to corner of section or other legal subdivision)

being within NE 1/4 of NE 1/4 of Sec. 11, Twp. 15 Rge. 10 W
(Smallest legal subdivision) (N. or S.) (E. or W.)

or (b) within limits of recorded platted property, town or city: Idaville Oregon

in Lot _____ Block _____ of _____
(Name of plat or addition)

County of _____
(If within city or town, give name)

3. Construction Work was begun on August 1953; was completed on or about Sept. 1, 1953
(Date) (Date)

and the ground water claimed was first used for the purposes set out below on Sept. 1st 1953
(Date)

since which time the water has been used continuously
(Continuously or intermittently)

from 8/53 to 7/30/58
(Date) (Date)

4. Quantity of water claimed and used is 350 gallons per minute; 2 acre feet per year.

5. Purpose or Purposes for which water is used exempt domestic and irrigation.
(Domestic, irrigation, municipal, manufacturing, industrial, etc.)

6. Description of Well: Depth 42 feet. Type drilled
(Dug or drilled)

diameter 6 inches. Elevation of ground at well site about 10 feet, mean sea level.
(As near as known)

Depth to water table 15 feet.

7. Capacity of Well: 500 g.p.m. with 20 feet drawdown.

_____ g.p.m. with _____ feet drawdown.


Date of test No. date but estimate by responsible people.

If Flowing Well: Measured discharge _____ g.p.m. on _____
(Date)

Shut-in pressure at ground surface _____ lbs. per sq. in. on _____
(Date)

Water is controlled by _____
(Cap, valve, etc.)

Township 13R Range 10W, W.M.
North

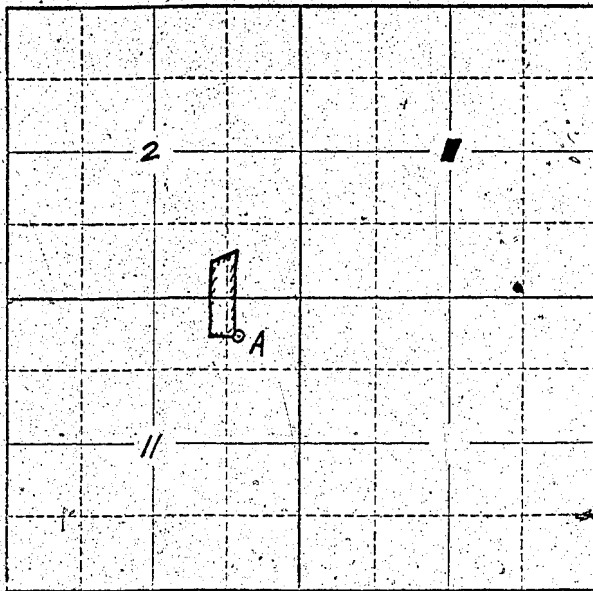

Locate well and acreage of irrigated land on plat.
Scale: 2" = 1 Mile

STATE OF OREGON

County of Tillamook } ss.

I, Bernice Wilkins, being first duly sworn, do hereby certify that I have read the foregoing Registration Statement and that all of the items therein contained are true to the best of my knowledge and belief.

Bernice Wilkins
(Signature of Registrant)

Subscribed and sworn to before me this 30th day of July, 19 58

My commission expires 2/2/62

Thomas M. Minnie

Notary Public for Oregon
My Commission Expires: 2/2/62

(SEAL)

CERTIFICATE OF REGISTRATION

STATE OF OREGON

County of Marion } ss.

This is to certify that the foregoing Registration Statement was received in the office of the State Engineer on the 1st day of August, 19 58 at 2.00 o'clock A.M. and has been duly recorded in said office in Book No. 16 of Registration Statements on page GR-3951

~~Construction shall be completed by _____ and the water conserved and used for _____~~

Witness my hand this 15th day of February, 19 60

Lewis A. Stanley
(State Engineer)

\$15.00

By _____ (Deputy)

GR-3951