

RECEIVED
AUG 1 1958
STATE ENGINEER
SALEM, OREGON

Registration Statement

REGISTRATION NO. GR-374

CERTIFICATE NO. GR-3393

OF CLAIMANT OF RIGHT TO APPROPRIATE GROUND WATER

(Under Chapter 708, Oregon Laws 1955.)

TO THE STATE ENGINEER OF OREGON:

ASSIGNED, See Misc. Rec., Vol. 4 Page 22

I, Paul W. Seely
of Highville County of Clackamas

State of Oregon, do hereby make application for a certificate of registration as evidence of a right to appropriate ground water.

1. Source from which water is withdrawn is Well
(Flowing well, pump well, infiltration trench, or tunnel)

2. Location is: 1/2 mile N. of Highville
(Approximate distance and direction from nearest city or town)

and is more particularly described as follows:

(a) N. 15' W. 1790 feet from southeast corner of Section 14
(Give distance and bearing to corner of section or other legal subdivision)

being within N.E. 1/4 S.W. 1/4 of Sec. 14, Twp. 3 S., Rge. 7 W.
(Smallest legal subdivision) (N. or S.) (E. or W.)

or (b) within limits of recorded platted property, town or city:

in Lot _____, Block _____ of _____
(Name of plat or addition)

County of Clackamas
(If within city or town, give name)

3. Construction Work was begun on 11/5/48; was completed on 11/5/48
(Date) (Date)

and the ground water claimed was first used for the purposes set out below on 11/5/48
(Date)

since which time the water has been used intermittently
(Continuously or intermittently)

from July 1948 to 2-1-75
(Date) (Date)

4. Quantity of water claimed and used is 1/2 gallons per minute; _____ acre feet per year.

5. Purpose or Purposes for which water is used _____
(Domestic, irrigation, municipal, manufacturing, industrial, etc.)

6. Description of Well: Depth 21.5 feet. Type Dug
(Dug or drilled)

diameter _____ inches. Elevation of ground at well site _____ feet, mean sea level.
(As near as known)

Depth to water table _____ feet.

7. Capacity of Well: 175 g.p.m. with _____ feet drawdown.
_____ g.p.m. with _____ feet drawdown.

Date of test _____

If Flowing Well: Measured discharge _____ g.p.m. on _____
(Date)

Shut-in pressure at ground surface _____ lbs. per sq. in. on _____
(Date)

Water is controlled by _____
(Cap, valve, etc.)

8. Casing: (Give diameter, commercial specifications and depth below ground surface of each casing size.)

..... inch diameter from to feet
..... inch diameter from to feet
..... inch diameter from to feet
..... inch diameter from to feet

Describe and show depth of shoe, plug, adapter, liner or other details:

9. Perforated Casings or Screens:

(Number per foot and size of perforations, or describe screen) from to
..... from to
..... from to
..... from to

10. Log of Well: (Describe each stratum or formation clearly, indicate if water bearing, and give thickness and depth as indicated.)

| MATERIAL | Thickness (Feet) | Depth to Bottom (Feet) |
|-------------------------------|------------------|------------------------|
| <i>1/2" - 1/4" sand</i> | <i>0.0-4'</i> | |
| <i>1/2" - 1/4" Bull. 3/4"</i> | <i>4-11'</i> | |
| | | |
| | | |
If log of well is not available, give name and address of driller.

11. Infiltration Trench: Covered or open

Dimensions: Length ft. Minimum depth ft. Maximum depth ft.

Bottom width ft. Discharge g.p.m. Date of test

12. Tunnel: Type of lining

Dimensions: (Length, course, and cross sectional size)

Position of water bearing stratum with reference to portal of tunnel

Log of tunnel: (Preceding table for log of well may be used, if desired. Give footage from portal and character of materials, as pertinent.)

13. Pumping Equipment:

(a) Pump *centrifugal* Capacity *400* g.p.m.
(Make, type and size)


(b) Motor *Electric Impulsion* *55 H.P.*
(Type and horsepower)

14. Location of area irrigated or to be irrigated, or place of use if for purposes other than irrigation.

| Township North or South | Range E. or W. of Willamette Meridian | Section | Forty-acre Tract | Number Acres To Be Irrigated | Date of Reclamation |
|----------------------------|--|-----------|------------------|---------------------------------|------------------------|
| <i>S. 5</i> | <i>7 N.</i> | <i>14</i> | <i>168-378</i> | | <i>1949</i> |
| | | | | | |
| | | | | | |
15. If the ground water supply is supplemental to an existing water supply, identification of any application for a permit, permit, certificate or adjudicated right to appropriate water made or held by the registrant.

Township 3.05 Range 11 W.M.
North

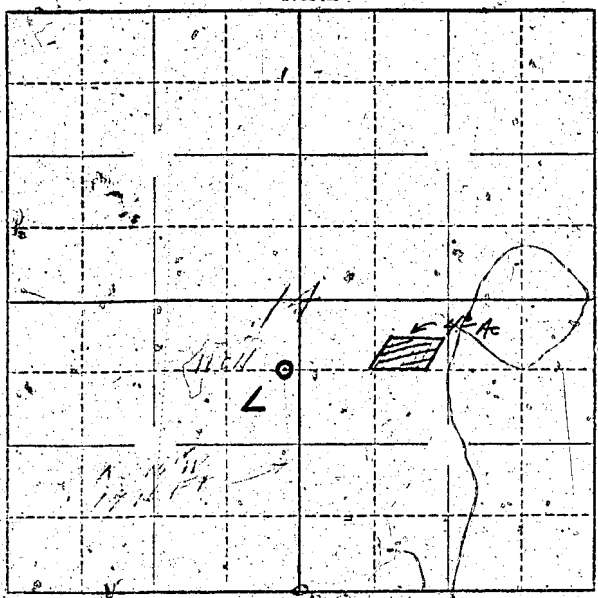

Locate well and acreage of irrigated land on plat.
Scale: 2" = 1 Mile

STATE OF OREGON

County of Marion ss.

I, Mark B. Seely being first duly sworn, do hereby certify that I have read the foregoing Registration Statement and that all of the items therein contained are true to the best of my knowledge and belief.

(Signature of Registrant)

Subscribed and sworn to before me this _____ day of _____ 19____

My commission expires _____

(Notary Public)

(SEAL)

NOTARY PUBLIC FOR OREGON
My Commission Expires July 22, 1959

CERTIFICATE OF REGISTRATION

STATE OF OREGON

County of Marion ss.

This is to certify that the foregoing Registration Statement was received in the office of the State Engineer on the 1 day of August 1958, at 8:00 o'clock A.M. and has been duly recorded in said office in Book No. 14 of Registration Statements on page GR-3393

~~XX Construction shall be completed by _____ and the water completely applied to beneficial use by _____ XX~~

Witness my hand this 1 20th day of August 1959

Lewis J. Stanley
(State Engineer)

By _____
(Deputy)

\$15.00

GR-3393