

RECEIVED
AUG 1 1958

STATE ENGINEER
SALEM, OREGON

Registration No. GR-3717

Certificate No. GR-3974

Registration Statement

OF CLAIMANT OF RIGHT TO APPROPRIATE GROUND WATER

TO THE STATE ENGINEER OF OREGON:

I, Charles R. Bayless

of Philomath, Oregon
(Mailing address)

County of Benton

State of Oregon, do hereby make application for a certificate of registration as evidence of a right to appropriate ground water.

1. Source from which water is withdrawn is Pump Well
(Flowing well, pump well, infiltration trench, or tunnel)

2. Location is: 1000 feet north of North boundary of Philomath
(Approximate distance and direction from nearest city or town)

and is more particularly described as follows:

(a) about 660 feet south & 1250 feet west from NE corner Section 12
(Give distance and bearing to corner of section or other legal subdivision)

being within NE 1/4 of NE 1/4 of Sec. 12, Twp. 12S, Rge. 6 W.
(Smallest legal subdivision) (N. or S.) (E. or W.)

or (b) within limits of recorded platted property, town or city:

in Lot _____, Block _____ of _____
(Name of plat or addition)

County of _____
(If within city or town, give name)

3. Construction Work was begun on September 1950; was completed on September 1950
(Date) (Date)

and the ground water claimed was first used for the purposes set out below on October 1950
(Date)

since which time the water has been used Continuously

(Continuously or intermittently)

from October 1950 to Present time
(Date) (Date)

4. Quantity of water claimed and used is 60 gallons per minute; _____ acre feet per year.

5. Purpose or Purposes for which water is used Will Pond & Irrigating of 5 acres

(Domestic, irrigation, municipal, manufacturing, industrial, etc.)

6. Description of Well: Depth 170 feet; Type Drilled

(Dug or drilled)

diameter 10 inches. Elevation of ground at well site 279 feet (mean sea level).

(As near as known)

Depth to water table 140/145 feet feet.

7. Capacity of Well: 70 g.p.m. with 170 feet drawdown.

_____ g.p.m. with _____ feet drawdown.

Date of test _____

If Flowing Well: Measured discharge _____ g.p.m. on _____

(Date)

Shut-in pressure at ground surface _____ lbs. per sq. in. on _____

(Date)

Water is controlled by _____

(Cap, valve, etc.)

8. Casing: (Give diameter, commercial specifications and depth below ground surface of each casing size.)

10 inch diameter from 0 to 24 feet
 inch diameter from to feet
 inch diameter from to feet
 inch diameter from to feet

Describe and show depth of shoe, plug, adapter, liner or other details:

9. Perforated Casings or Screens:

..... none from to
(Number per foot and size of perforations, or describe screen)
 from to
 from to
 from to

10. Log of Well: (Describe each stratum or formation clearly, indicate if water bearing, and give thickness and depth as indicated.)

MATERIAL	Thickness (Feet)	Depth to Bottom (Feet)
Clay	0	60
Clay & Grit	60	80
Gray Rock	80	100
Black Rock	100	110
Gray Rock	110	120
Brownish Gray Rock	120	130
Gray Rock with Quartz	130	150

If log of well is not available, give name and address of driller.

11. Infiltration Trench: Covered or open

Dimensions: Length ft. Minimum depth ft. Maximum depth ft.

Bottom width ft. Discharge g.p.m. Date of test

12. Tunnel: Type of lining

Dimensions: (Length, course, and cross sectional size)

Position of water bearing stratum with reference to portal of tunnel

Log of tunnel: (Preceding table for log of well may be used, if desired. Give footage from portal and character of materials, as pertinent.)

13. Pumping Equipment:

(a) Pump *Lucas Boulder deep well pump* Capacity *80* g.p.m.
(Make, type and size)


(b) Motor *10 HP Electric*
(Type and horsepower)

14. Location of area irrigated or to be irrigated, or place of use if for purposes other than irrigation.

Township North or South	Range E. or W. of Willamette Meridian	Section	Forty-acre Tract	Number Acres To Be Irrigated	Date of Reclamation
<i>12 S</i>	<i>6 W</i>	<i>12</i>	<i>N.E. 1/4 + NE 1/4</i>	<i>5</i>	<i>1950</i>

15. If the ground water supply is supplemental to an existing water supply, identification of any application for a permit, permit, certificate or adjudicated right to appropriate water made or held by the registrant.

Township 12 S y Range 6 W W.M.
North

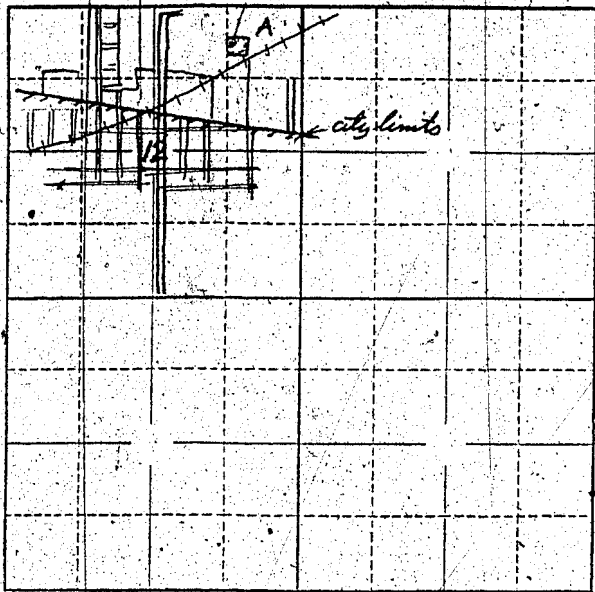

Locate well and acreage of irrigated land on plat.
Scale: 2" = 1 Mile

STATE OF OREGON

County of Benton

ss.

I, Charles R. Bayless, being first duly sworn, do hereby certify that I have read the foregoing Registration Statement and that all of the items therein contained are true to the best of my knowledge and belief.

Charles R. Bayless
(Signature of Registrant)

Subscribed and sworn to before me this 3 day of July, 1960

My commission expires Jan 21, 1960

Harold A. [unclear]
(Notary Public)

(SEAL)

CERTIFICATE OF REGISTRATION

STATE OF OREGON

County of Marion

ss.

This is to certify that the foregoing Registration Statement was received in the office of the State Engineer on the 15th day of August, 1960, at 8:00 o'clock A.M. and has been duly recorded in said office in Book No. 16 of Registration Statements on page GR-3974

Witness my hand this 15th day of February, 1960

Lewis A. Stanley
(State Engineer)

By _____ (Deputy)

\$15.00

GR 3974