

Registration Statement

OF CLAIMANT OF RIGHT TO APPROPRIATE GROUND WATER

TO THE STATE ENGINEER OF OREGON:

I, Philip A. McKenzie and M. Evelyn McKenzie

of 1155 Norkenzie Rd. Eugene, Oregon County of Lane

State of Oregon, do hereby make application for a certificate of registration as evidence of a right to appropriate ground water.

1. Source from which water is withdrawn is Pump well (Flowing well, pump well, infiltration trench, or tunnel)

2. Location is: 4 miles north of Eugene (Approximate distance and direction from nearest city or town)

and is more particularly described as follows:

(a) 1262' South and 359' West of the SW cor. of the Alvin B. Stevens D.I.C. 40 (Give distance and bearing to corner of section or other legal subdivision)

being within SE 1/4 of Sec. 18, Twp. 17S, Rge. 3W (Smallest legal subdivision) (N. or S.) (E. or W.)

or (b) within limits of recorded platted property, town or city:

in Lot _____, Block _____ of _____ County of _____ (Name of plat or addition) (If within city or town, give name)

3. Construction Work was begun on May 1954; was completed on June 1954 (Date) (Date)

and the ground water claimed was first used for the purposes set out below on June 1954 (Date)

since which time the water has been used intermittently (Continuously or intermittently)

from June 1954 to July 1958 (Date) (Date)

4. Quantity of water claimed and used is 200 gallons per minute; acre feet per year.

5. Purpose or Purposes for which water is used irrigation (Domestic, irrigation, municipal, manufacturing, industrial, etc.)

6. Description of Well: Depth 20 feet. Type driven (Dug or drilled)

diameter 2-2 1/2 inches. Elevation of ground at well site unknown 400 feet, mean sea level. (As near as known)

Depth to water table 12 feet. not tested

7. Capacity of Well: 250 g.p.m. with _____ feet drawdown. _____ g.p.m. with _____ feet drawdown.

Date of test not tested

If Flowing Well: Measured discharge _____ g.p.m. on _____ (Date)

Shut-in pressure at ground surface _____ lbs. per sq. in. on _____ (Date)

Water is controlled by _____ (Cap, valve, etc.)

8. **Casing:** (Give diameter, commercial specifications and depth below ground surface of each casing size.)

two 2 inch diameter wells 20 feet long from to feet
 inch diameter from to feet
 inch diameter from to feet
 inch diameter from to feet

Describe and show depth of shoe, plug, adapter, liner or other details:

9. **Perforated Casings or Screens:**

perforated with 3/8 in. holes 2 in apart for three feet from the bottom
(Number per foot and size of perforations, or describe screen) from to
 from to
 from to

10. **Log of Well:** (Describe each stratum or formation clearly, indicate if water bearing, and give thickness and depth as indicated.)

MATERIAL	Thickness (Feet)	Depth to Bottom (Feet)

If log of well is not available, give name and address of driller.

11. Infiltration Trench: Covered or open

Dimensions: Length ft. Minimum depth ft. Maximum depth ft.

Bottom width ft. Discharge g.p.m. Date of test

12. Tunnel: Type of lining

Dimensions: (Length, course, and cross sectional size)

Position of water bearing stratum with reference to portal of tunnel

Log of tunnel: (Preceding table for log of well may be used, if desired. Give footage from portal and character of materials, as pertinent.)

13. Pumping Equipment:

(a) Pump 2 by 10 Fairbanks-Morse Centrifugal Capacity 200 g.p.m. (Make, type and size)

(b) Motor 10 H. P. Fairbanks-Morse 3 phase (Type and horsepower)


14. Location of area irrigated or to be irrigated, or place of use if for purposes other than irrigation.

Table with 6 columns: Township North or South, Range E. or W. of Willamette Meridian, Section, Forty-acre Tract, Number Acres To Be Irrigated, Date of Reclamation. Includes handwritten entries for townships 17S and 18S, sections 13 and 15, and a total of 10.51 acres.

15. If the ground water supply is supplemental to an existing water supply, identification of any application for a permit, permit, certificate or adjudicated right to appropriate water made or held by the registrant.

Township 17 S Range 3 W, W.M.

North

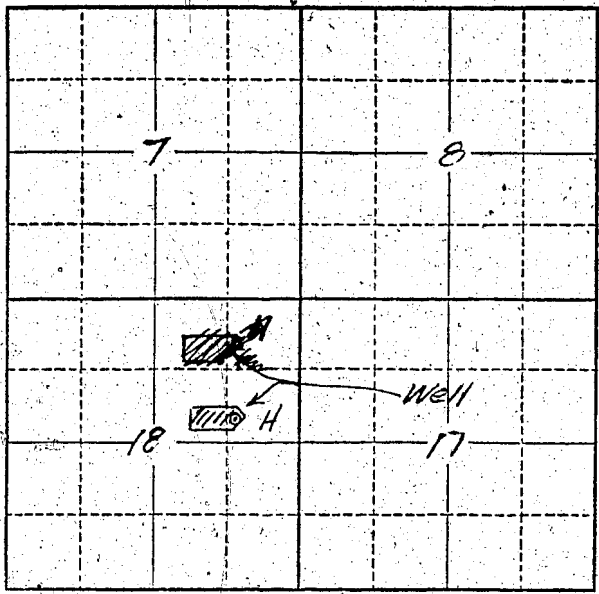

Locate well and acreage of irrigated land on plat.

Scale: 2" = 1 Mile

STATE OF OREGON

County of Lane } ss.

I, Philip A. McKenzie, being first duly sworn, do hereby certify that I have read the foregoing Registration Statement and that all of the items therein contained are true to the best of my knowledge and belief.

Philip A. McKenzie
(Signature of Registrant)

Subscribed and sworn to before me this 31st day of July, 1958

My commission expires January 1, 1959

Robert P. Blanting
(Notary Public)

(SEAL)

CERTIFICATE OF REGISTRATION

STATE OF OREGON } ss.
County of Marion

This is to certify that the foregoing Registration Statement was received in the office of the State Engineer on the 1st day of August, 1958, at 8:00 o'clock A. M. and has been duly recorded in said office in Book No. 14 of Registration Statements on page GR 3396

Witness my hand this 20th day of August, 1959

Lewis A. Stanley
(State Engineer)

By _____
(Deputy)

\$15.00

GR 3396