

RECEIVED
AUG 1 1958

STATE ENGINEER
SALEM, OREGON

RECEIVED
JAN 19 1950

STATE ENGINEER
SALEM, OREGON

Registration Statement

Registration No. GR-3723

Certificate No. GR-3922

CLAIMANT OF RIGHT TO APPROPRIATE GROUND WATER

TO THE STATE ENGINEER OF OREGON:

I, J. L. Hovey
of Rt 4 Box 328, Corvallis County of Linn
(Mailing address)

State of Oregon, do hereby make application for a certificate of registration as evidence of a right to appropriate ground water.

1. Source from which water is withdrawn is Pump Well
(Flowing well, pump well, infiltration trench, or tunnel)
2. Location is: 2 miles East of Corvallis, Oregon
(Approximate distance and direction from nearest city or town)

and is more particularly described as follows:

(a) _____
(Give distance and bearing to corner of section or other legal subdivisions)
being within NE 1/4 NW 1/4 NE 1/4 of Sec. 6, Twp. 13 S, Rge. 4 W
(Smallest legal subdivision) (N. or S.) (E. or W.)

or (b) within limits of recorded platted property, town or city: _____
in Lot _____, Block _____ of _____
(Name of plat or addition)

County of _____
(If within city or town, give name)

3. Construction Work was begun on May 1952; was completed on May 1952
(Date) (Date)
and the ground water claimed was first used for the purposes set out below on July 1952
(Date)

since which time the water has been used intermittently
(Continuously or intermittently)
from July 1952 to July 1958
(Date) (Date)

4. Quantity of water claimed and used is 140 gallons per minute; _____ acre feet per year.

5. Purpose or Purposes for which water is used Irrigation

(Domestic, irrigation, municipal, manufacturing, industrial, etc.)

6. Description of Well: Depth 39 feet. Type Drilled
(Dug or drilled)
diameter 8 inches. Elevation of ground at well site _____ feet, mean sea level.
(As near as known)
Depth to water table 15 feet.

7. Capacity of Well: 300 g.p.m. with 1.4 feet drawdown.
_____ g.p.m. with _____ feet drawdown.

Date of test May 1952

If Flowing Well: Measured discharge _____ g.p.m. on _____
(Date)

Shut-in pressure at ground surface _____ lbs. per sq. in. on _____
(Date)

Water is controlled by _____
(Cap, valve, etc.)

8. **Casing:** (Give diameter, commercial specifications and depth below ground surface of each casing size.)

8 inch diameter from Surface to 35 feet
..... inch diameter from to feet
..... inch diameter from to feet
..... inch diameter from to feet

Describe and show depth of shoe, plug, adapter, liner or other details:
.....
.....

9. **Perforated Casings or Screens:**

..... from to
(Number per foot and size of perforations, or describe screen)
..... from to
..... from to
..... from to

10. **Log of Well:** (Describe each stratum or formation clearly, indicate if water bearing, and give thickness and depth as indicated.)

MATERIAL	Thickness (Feet)	Depth to Bottom (Feet)

If log of well is not available, give name and address of driller. C. A. Shafer

Philomath, Oregon

11. Infiltration Trench: Covered or open _____
 Dimensions: Length _____ ft. Minimum depth _____ ft. Maximum depth _____ ft.
 Bottom width _____ ft. Discharge _____ g.p.m. Date of test _____

12. Tunnel: Type of lining _____
 Dimensions: _____
(Length, course, and cross sectional size)
 Position of water bearing stratum with reference to portal of tunnel _____

Log of tunnel: (Preceding table for log of well may be used, if desired. Give footage from portal and character of materials, as pertinent.)


13. Pumping Equipment:
 (a) Pump Fambach Motor Power Lumber Capacity 150 g.p.m.
(Make, type and size)
 (b) Motor 5 horse single phase electric
(Type and horsepower)

14. Location of area irrigated or to be irrigated; or place of use if for purposes other than irrigation.

Township North or South	Range E. or W. of Willamette Meridian	Section	Forty-acre Tract	Number Acres To Be Irrigated	Date of Reclamation
<u>12 S</u>	<u>4 W</u>	<u>6</u>	<u>N W 1/4 of NE 1/4</u>	<u>15.0</u>	<u>July 1952</u>

15. If the ground water supply is supplemental to an existing water supply, identification of any application for a permit, permit, certificate or adjudicated right to appropriate water made or held by the registrant.

Township 12 S Range 4 W W.M.
North

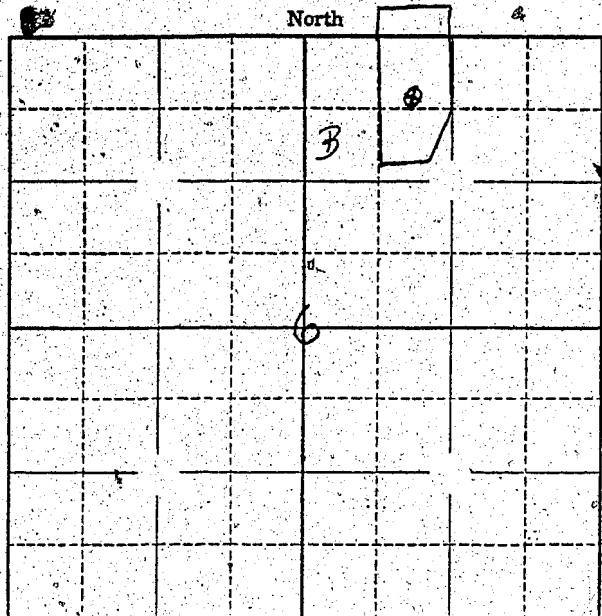

Locate well and acreage of irrigated land on plat.
Scale: 2" = 1 Mile

STATE OF OREGON

County of Benton } ss.

I, J. L. Hovey, being first duly sworn, do hereby certify that I have read the foregoing Registration Statement and that all of the items therein contained are true to the best of my knowledge and belief.

J. L. Hovey
(Signature of Registrant)

Subscribed and sworn to before me this 30th day of July, 1957

My commission expires NOTARY PUBLIC FOR OREGON
My Commission Expires Dec. 11, 1958

(Notary Public)

(SEAL)

CERTIFICATE OF REGISTRATION

STATE OF OREGON

County of Marion } ss.

This is to certify that the foregoing Registration Statement was received in the office of the State Engineer on the 1st day of August, 1958, at 8:00 o'clock A.M. and has been duly recorded in said office in Book No. 16 of Registration Statements on page 62-3922

Witness my hand this 15th day of February, 1960

Linda A. Stanley
(State Engineer)

By _____
(Deputy)

\$15.00