

RECEIVED

FEB 18 1957

STATE ENGINEER
SALEM, OREGON

Registration Statement

REGISTRATION NO. GR-373
CERTIFICATE NO. GR 359

OF CLAIMANT OF RIGHT TO APPROPRIATE GROUND WATER

(Under Chapter 708, Oregon Laws 1955.)

TO THE STATE ENGINEER OF OREGON:

I, Elton I. and Mildred Higbee and Henry and Pauline Turnidge

of Rt. 2, Box 369, Albany County of Linn

State of Oregon, do hereby make application for a certificate of registration as evidence of a right to appropriate ground water.

1. Source from which water is withdrawn is Pump Well No. 1
(Casing well, pump well, infiltration trench, or tunnel)

2. Location is: 3 miles west of Jefferson, Oregon
(Approximate distance and direction from nearest city or town)

and is more particularly described as follows:

(a) N. 20° W. 11.8 chains from the SE 1/4 of NE 1/4 of S. 4, T. 10 S., R. 3 W.
(Give distance and bearing to corner of section or other legal subdivision)

being within SE 1/4 of NE 1/4 of Sec. 4, Twp. 10 S., Rge. 3 W.
(Smallest legal subdivision) (N. or S.) (E. or W.)

or (b) within limits of recorded platted property, town or city:

in Lot _____, Block _____ of _____
(Name of plat or addition)

County of Linn
(If within city or town, give name)

3. Construction Work was begun on April 10, 1946; was completed on April 15, 1946
(Date) (Date)

and the ground water claimed was first used for the purposes set out below on May 20, 1946
(Date)

since which time the water has been used continuously
(Continuously or intermittently)

from May 20, 1946 to present time
(Date) (Date)

4. Quantity of water claimed and used is 210 gallons per minute; 47.25 acre feet per year.

5. Purpose or Purposes for which water is used Irrigation

(Domestic, irrigation, municipal, manufacturing, industrial, etc.)

6. Description of Well: Depth 22 feet. Type Drilled
(Dug or drilled)

diameter 4 inches. Elevation of ground at well site 195 feet, mean sea level.
(As near as known)

Depth to water table 10 feet.

7. Capacity of Well: 300 g.p.m. with 3 feet drawdown.

 g.p.m. with feet drawdown.

Date of test Not tested

If Flowing Well: Measured discharge g.p.m. on (Date)

Shut-in pressure at ground surface lbs. per sq. in. on (Date)

Water is controlled by
(Cap. valve, etc.)

8. Casing: (Give diameter, commercial specifications and depth below ground surface of each casing size.)

4 inch diameter steel casing from 0 to 18 feet
 inch diameter from to feet
 inch diameter from to feet
 inch diameter from to feet

Describe and show depth of shoe, plug, adapter, liner or other details: _____


9. Perforated Casings or Screens:

Slit perforations from 13 to 18
 (Number per foot and size of perforations, or describe screen)
 from to
 from to
 from to

10. Log of Well: (Describe each stratum or formation clearly, indicate if water bearing, and give thickness and depth as indicated.)

MATERIAL	Thickness (Feet)	Depth to Bottom (Feet)
Soil	8	8
Sand	2	10
River Rock	12	22

Township 10 S Range 3 W W.M.
North

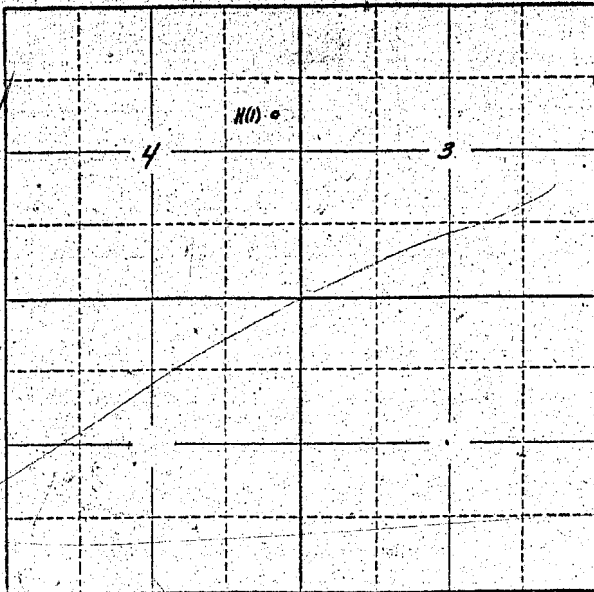

Locate well and acreage of irrigated land on plat.
Scale: 2" = 1 Mile

STATE OF OREGON

County of Linn } ss.

Elton I. and Mildred Higbee

I, Henry and Pauline Turnidge, being first duly sworn, do hereby certify that I have read the foregoing Registration Statement and that all of the items therein contained are true to the best of my knowledge and belief.

Elton I Higbee Mildred S Higbee J. H. Turnidge Pauline S. Turnidge
(Signature of Registrant)

Subscribed and sworn to before me this 14 day of February, 1957

My commission expires Nov 29 1959 Robert R. Guther
(Notary Public)

(SEAL)

See Page GR-359 K for
CERTIFICATE OF REGISTRATION

STATE OF OREGON

County of Marion } ss.

~~XX This is to certify that the foregoing Registration Statement was received in the office of the State Engineer on the 14 day of February, 1957 at Linn and has been duly recorded in said office in Book No. 100 of Registration Statements on page 4~~

~~Construction work completed by 100 and the water completely applied to beneficial use by 100~~

Witness my hand this _____ day of _____, 19____

(State Engineer)

By _____
(Deputy)

RECEIVED

FEB 18 1957
STATE ENGINEER
SALEM, OREGON

REGISTRATION NO. GR-373
GR 359

Registration Statement CERTIFICATE NO. _____

OF CLAIMANT OF RIGHT TO APPROPRIATE GROUND WATER

(Under Chapter 708, Oregon Laws 1955.)

TO THE STATE ENGINEER OF OREGON:

I, Elton I. and Mildred Higbee and Henry and Pauline Turnidge
of Rt. 2, Box 369, Albany County of Linn

State of Oregon, do hereby make application for a certificate of registration as evidence of a right to appropriate ground water.

1. Source from which water is withdrawn is Pump Well No. 2
(Flowing well, pump well, infiltration trench, or tunnel)

2. Location is: 3 miles west of Jefferson, Oregon
(Approximate distance and direction from nearest city or town)

and is more particularly described as follows:

(a) N. 30° 20' E. 20.5 chains from the SE corner of NE 1/4 of S. 4, T. 10 S., R. 3 W.
(Give distance and bearing to corner of section or other legal subdivision)

being within SW 1/4 of NW 1/4 of Sec. 3, Twp. 10 S., Rge. 3 W.
(Smallest legal subdivision) (N. or S.) (E. or W.)

or (b) within limits of recorded platted property, town or city:

in Lot _____, Block _____ of _____
(Name of plat or addition)

County of Linn
(If within city or town, give name)

3. Construction Work was begun on April 19, 1946; was completed on April 24, 1946
(Date) (Date)

and the ground water claimed was first used for the purposes set out below on May 28, 1946
(Date)

since which time the water has been used continuously
(Continuously or intermittently)

from May 28, 1946 to present time
(Date) (Date)

4. Quantity of water claimed and used is 294 gallons per minute; 130 acre feet per year.

5. Purpose or Purposes for which water is used Irrigation

(Domestic, irrigation, municipal, manufacturing, industrial, etc.)

6. Description of Well: Depth 24 feet. Type Drilled
(Dug or drilled)

diameter 10 inches. Elevation of ground at well site 195 feet, mean sea level.
(As near as known)

Depth to water table 10 feet.

7. Capacity of Well: 600 g.p.m. with 3 feet drawdown.

_____ g.p.m. with _____ feet drawdown.

Date of test Not tested

If Flowing Well: Measured discharge _____ g.p.m. on _____
(Date)

Shut-in pressure at ground surface _____ lbs. per sq. in. on _____
(Date)

Water is controlled by _____
(Cap, valve, etc.)

GR 359 D

8. Casing: (Give diameter, commercial specifications and depth below ground surface of each casing size.)

10 inch diameter steel casing from 0 to 20 feet
inch diameter from to feet
inch diameter from to feet
inch diameter from to feet

Describe and show depth of shoe, plug, adapter, liner or other details:

9. Perforated Casings or Screens:

Slit perforations from 12 to 20
(Number per foot and size of perforations, or describe screen)
from to
from to
from to

10. Log of Well: (Describe each stratum or formation clearly, indicate if water bearing, and give thickness and depth as indicated.)

MATERIAL	Thickness (Feet)	Depth to Bottom (Feet)
Soil	6	6
Sand	3	9
River Gravel	11	20

If log of well is not available, give name and address of driller.

11. Infiltration Trench: Covered or open

Dimensions: Length ft. Minimum depth ft. Maximum depth ft.

Bottom width ft. Discharge g.p.m. Date of test

12. Tunnel: Type of lining

Dimensions: (Length, course, and cross sectional size)

Position of water bearing stratum with reference to portal of tunnel

Log of tunnel: (Preceding table for log of well may be used, if desired. Give footage from portal and character of materials, as pertinent.)

13. Pumping Equipment:

(a) Pump Fairbanks Morse 3rd Centrifugal Capacity 300 g.p.m. (Make, type and size)

(b) Motor 15 H. P. electric (Type and horsepower)


14. Location of area irrigated or to be irrigated, or place of use if for purposes other than irrigation.

Township North or South	Range E. or W. of Willamette Meridian	Section	Forty-acre Tract	Number Acres To Be Irrigated	Date of Reclamation
10 S	3 W	4	SE $\frac{1}{4}$ of NE $\frac{1}{4}$	5.3	May 28, 1946
10 S	3 W	4	NE $\frac{1}{4}$ of NE $\frac{1}{4}$	4.7	May 28, 1946
10 S	3 W	3	NW $\frac{1}{4}$ of NW $\frac{1}{4}$	17.8	May 28, 1946
10 S	3 W	3	SW $\frac{1}{4}$ of NW $\frac{1}{4}$	24.2	May 28, 1946
				52.0	

15. If the ground water supply is supplemental to an existing water supply, identification of any application for a permit, permit, certificate or adjudicated right to appropriate water made or held by the registrant.

Township 10 S Range 3 W W.M.

North

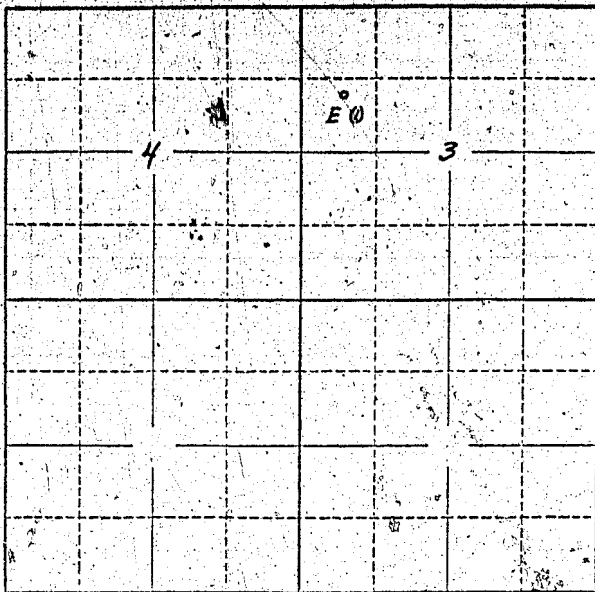

Locate well and acreage of irrigated land on plat.

Scale: 2" = 1 Mile

STATE OF OREGON

County of Linn } ss.

I, Elton I. and Mildred Higbee, Henry and Pauline Turnidge, being first duly sworn, do hereby certify that I have read the foregoing Registration Statement and that all of the items therein contained are true to the best of my knowledge and belief.

Elton I Higbee Mildred S Higbee J. P. Turnidge Pauline G. Turnidge (Signature of Registrant)

Subscribed and sworn to before me this 14th day of February, 1957

My commission expires Dec 27 1959 Robert R. Gutter (Notary Public)

(SEAL)

See Page GR-359 K for CERTIFICATE OF REGISTRATION

STATE OF OREGON

County of Marion } ss.

This certifies that the foregoing Registration Statement was received in the office of the State Engineer in the ... day of ... 19... and has been duly recorded in said office in Book No. ... of Registration Statements on page ...

Construction shall be completed by ... and the water completely applied to beneficial use by ...

Witness my hand this ... day of ... 19...

(State Engineer)

By (Deputy)

RECEIVED

FEB 18 1957
STATE ENGINEER
SALEM, OREGON

REGISTRATION NO. GR-373
CERTIFICATE NO. GR 359

Registration Statement

OF CLAIMANT OF RIGHT TO APPROPRIATE GROUND WATER

(Under Chapter 708, Oregon Laws 1955.)

TO THE STATE ENGINEER OF OREGON:

I, Elton I. and Mildred Higbee and Henry and Pauline Turnidge
of Rt. 2, Box 369, Albany County of Linn

State of Oregon, do hereby make application for a certificate of registration as evidence of a right to appropriate ground water.

- 1. Source from which water is withdrawn is Pump Well No. 3
(Flowing well, pump well, infiltration trench, or tunnel)
- 2. Location is: 3 miles west of Jefferson, Oregon
(Approximate distance and direction from nearest city or town)

and is more particularly described as follows:

(a) N. 15° W. 20.5 chains from the SE corner of NE 1/4 of S. 4, T. 10 S, R. 3 W.
(Give distance and bearing to corner of section or other legal subdivision)
being within SE 1/4 of NE 1/4 of Sec. 4, Twp. 10 S Rge. 3 W
(Smallest legal subdivision) (N. or S.) (E. or W.)

or (b) within limits of recorded platted property, town or city:
in Lot _____, Block _____ of _____
(Name of plat or addition)
County of Linn
(If within city or town, give name)

3. Construction Work was begun on April 10, 1950; was completed on April 12, 1950
(Date) (Date)

and the ground water claimed was first used for the purposes set out below on May 20, 1950
(Date)
since which time the water has been used continuously
(Continuously or intermittently)

from May 20, 1950 to present time
(Date) (Date)

4. Quantity of water claimed and used is 210 gallons per minute; 85.75 acre feet per year.

5. Purpose or Purposes for which water is used Irrigation

6. Description of Well: Depth 22 feet. Type drilled
(Dug or drilled)
diameter 8 inches. Elevation of ground at well site 195 feet, mean sea level.
(As near as known)
Depth to water table 5 feet.

7. Capacity of Well: 350 g.p.m. with 2 feet drawdown.
_____ g.p.m. with _____ feet drawdown.

Date of test: Not tested

If Flowing Well: Measured discharge _____ g.p.m. on _____
(Date)

Shut-in pressure at ground surface _____ lbs. per sq. in. on _____
(Date)

Water is controlled by _____
(Cap, valve, etc.)

GR 359 H

8. Casing: (Give diameter, commercial specifications and depth below ground surface of each casing size.)

8 inch diameter Steel casing from 0 to 22 feet
 inch diameter from to feet
 inch diameter from to feet
 inch diameter from to feet

Describe and show depth of shoe, plug, adapter, liner or other details:

9. Perforated Casings or Screens:

Slit perforations from 18 to 22
 (Number per foot and size of perforations, or describe screen)

from to

from to

from to

10. Log of Well: (Describe each stratum or formation clearly, indicate if water bearing, and give thickness and depth as indicated.)

MATERIAL	Thickness (Feet)	Depth to Bottom (Feet)
Soil	6	6
Sand	3	9
River Gravel	13	22

217-718

Beginning at a quarter section post on the East side of Section 4, in T. 10 S., R. 3 W. of the Will. Mer. in Linn County, Oregon; thence West 20 chains; thence North 28 chains; thence East 20 chains; thence South 28 chains on the Section line between 3 and 4 in said T. & R.; and containing 50 acres, more or less, situated in Linn County, State of Oregon. ALSO a right of way 9 feet wide on each of the following described line: Beginning at the Southeast corner of the Southwest quarter of the Northeast quarter of said section 4 and running N. 0° 35' E. 28 chains. EXCEPT therefrom that portion thereof heretofore conveyed to the State of Oregon by and through the Highway Commission said exception containing 0.54 acres.

187-459

Beginning at a point which is 46.17 chains North of the Southwest corner of section 3, T. 10 S., R. 3 W. of the Will. Mer. in Linn County, Oregon; and running thence east 80 rods to the East boundary line of the west half of the Northwest quarter of said Section 3; thence North 59 rods to the South bank of the Santiam River; thence Northwesterly along the South bank of the Santiam River a distance of 33 rods; thence West 51 rods to the West boundary line of said Section 3; thence South along the West boundary line of said section, 75 rods to the place of beginning EXCEPTING a strip of land 2 rods in width off of the West side of the above described premises and along said Section line, reserved for a road. ALSO, Beginning at a point which is 26.17 chains North of the Southwest corner of Section 3, in T. 10 S., R. 3 W. of the Will. Mer. in Linn County, Oregon; and running thence East 1,220 feet, to the East line of the lands conveyed by William H. Rhodes to Eber h. Rhodes by deed record on June 14, 1911, in Book 97, page 265 Deed Records thereof; thence North 22 chains; thence West 20 chains; thence South to the place of beginning, EXCEPTING 2 rods on the West side for a road on the above described property. ALSO, Beginning at a point 267.68 rods North of the Southwest corner of Section 3, in T. 10 S., R. 3 W. of the Will. Mer. in Linn County, Oregon; the same being the Northwest corner of a tract of land heretofore conveyed by W. F. Kennedy to Byron Hutchins, and running thence East 51 rods; to the South bank of the Santiam River; thence Northwesterly along the South bank of said Santiam River to the Western boundary line of said Section 3; thence South along the West line of said Section 3 to the place of beginning.

GR 359 I

If log of well is not available, give name and address of driller.

11. Infiltration Trench: Covered or open

Dimensions: Length ft. Minimum depth ft. Maximum depth ft.

Bottom width ft. Discharge g.p.m. Date of test

12. Tunnel: Type of lining

Dimensions:
(Length, course, and cross sectional size)

Position of water bearing stratum with reference to portal of tunnel

Log of tunnel: (Preceding table for log of well may be used, if desired. Give footage from portal and character of materials, as pertinent.)

13. Pumping Equipment:

(a) Pump Fairbanks Morse 2" Centrifugal Capacity 250 g.p.m.
(Make, type and size)


(b) Motor 10 H. P. electric
(Type and horsepower)

14. Location of area irrigated or to be irrigated, or place of use if for purposes other than irrigation.

Township North or South	Range E. or W. of Willamette Meridian	Section	Forty-acre Tract	Number Acres To Be Irrigated	Date of Reclamation
10 S	3 W	4	NE 1/4 of NE 1/4	9.1	May 20, 1950
10 S	3 W	4	SE 1/4 of NE 1/4	9.2	" "
				18.3	
"	"	"	NE 1/4 of NE 1/4	4.7	" "
"	"	"	SE 1/4 of NE 1/4	13.7	" "
				18.4	
Correction					
This well Not to be used for irrigation as land formerly irrigated by it will get water from New Well					
No G595					
Elton Highlee					

15. If the ground water supply is supplemental to an existing water supply, identification of any application for a permit, permit, certificate or adjudicated right to appropriate water made or held by the registrant.

Township 10 S Range 3 W, W.M.
North

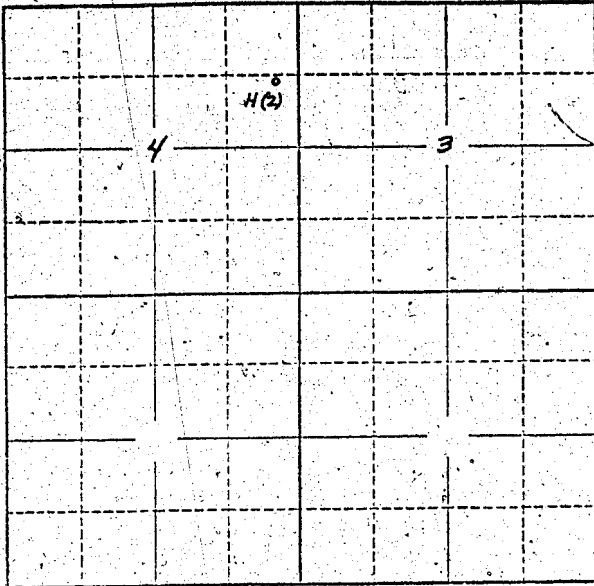

Locate well and acreage of irrigated land on plat.
Scale: 2" = 1 Mile

STATE OF OREGON

County of Linn } ss.

Elton I. and Mildred Higbee
I, Henry and Pauline Turnidge, being first duly sworn, do hereby certify that I have read the foregoing Registration Statement and that all of the items therein contained are true to the best of my knowledge and belief.

Elton I. Higbee Mildred S. Higbee J. H. Turnidge Pauline E. Turnidge
(Signature of Registrant)

Subscribed and sworn to before me this 14 day of February, 1957

My commission expires Dec 27, 1959 Robert P. Jackson
(Notary Public)

(SEAL)

CERTIFICATE OF REGISTRATION

STATE OF OREGON } ss.
County of Marion

This is to certify that the foregoing Registration Statement was received in the office of the State Engineer on the 18th day of February, 1957, at 8:00 o'clock A. M. and has been duly recorded in said office in Book No. 2 of Registration Statements on page GR-359 K.

~~XX Construction shall be completed by X-X-X-X-X-X-X-X, 19X-X, and the water completely applied to beneficiaries by X-X-X-X-X-X-X-X, 19X-X XX~~

Witness my hand this 23rd day of May, 1957

Lewis A. Stanley
(State Engineer)

By _____ (Deputy)

GR 359 K

19 95