

Registration Statement

OF CLAIMANT OF RIGHT TO APPROPRIATE GROUND WATER

TO THE STATE ENGINEER OF OREGON:

I, Carey L. Strome

of P. O. Box 548 Junction City, Oregon County of Lane

(Mailing address)

State of Oregon, do hereby make application for a certificate of registration as evidence of a right to appropriate ground water.

1. Source from which water is withdrawn is Driven Well #1
(Flowing well, pump well, infiltration trench, or tunnel)

2. Location is: 1 mi S. E. Junction City, Oregon
(Approximate distance and direction from nearest city or town)

and is more particularly described as follows:

(a) 3015' - S03°00'E of North West Corner of Section 4
(Give distance and bearing to corner of section or other legal subdivision)

being within NW, SW of Sec. 4, Twp. T16S, Rge. R4W
(Smallest legal subdivision) (N. or S.) (E. or W.)

or (b) within limits of recorded platted property, town or city:

in Lot _____, Block _____ of _____
(Name of plat or addition)

(If within city or town, give name)

County of _____

3. Construction Work was begun on Sept 15, 1952; was completed on Sept 22, 1952
(Date) (Date)

and the ground water claimed was first used for the purposes set out below on October 1952
(Date)

since which time the water has been used Intermittently
(Continuously or intermittently)

from May to Sept.
(Date) (Date)

4. Quantity of water claimed and used is 500 gallons per minute; _____ acre feet per year.

5. Purpose or Purposes for which water is used Irrigation

(Domestic, irrigation, municipal, manufacturing, industrial, etc.)

6. Description of Well: Depth 30 feet. Type Driven
(Dug or drilled)

diameter 2-6" inches. Elevation of ground at well site Manifolded feet, mean sea level.
(As near as known)

Depth to water table 9 feet.

7. Capacity of Well: 750 g.p.m. with 3 feet drawdown.

_____ g.p.m. with _____ feet drawdown.

Date of test October 1952

If Flowing Well: Measured discharge _____ g.p.m. on _____
(Date)

Shut-in pressure at ground surface _____ lbs. per sq. in. on _____
(Date)

Water is controlled by _____
(Cap, valve, etc.)

8. Casing: (Give diameter, commercial specifications and depth below ground surface of each casing size.)

6" i. d. inch diameter Steel from 0 to 30 feet
..... inch diameter from to feet
..... inch diameter from to feet
..... inch diameter from to feet

Describe and show depth of shoe, plug, adapter, liner or other details: Manifolded to 6"
well 20' away with 6" casing pipe.

9. Perforated Casings or Screens:

1/2" slots - 2' long from 25 to 30
(Number per foot and size of perforations, or describe screen)
..... from to
..... from to
..... from to

10. Log of Well: (Describe each stratum or formation clearly, indicate if water bearing, and give thickness and depth as indicated.)

MATERIAL	Thickness (Feet)	Depth to Bottom (Feet)

If log of well is not available, give name and address of driller. Everett Scott,
2846 Hwy 99E, Route 1, Harrisburg, Oregon

11. Infiltration Trench: Covered or open
 Dimensions: Length ft. Minimum depth ft. Maximum depth ft.
 Bottom width ft. Discharge g.p.m. Date of test

12. Tunnel: Type of lining
 Dimensions:
(Length, course, and cross sectional size)
 Position of water bearing stratum with reference to portal of tunnel

Log of tunnel: (Preceding table for log of well may be used, if desired. Give footage from portal and character of materials, as pertinent.)


13. Pumping Equipment:
 (a) Pump Cornell -4"x5"- Shallow Well Capacity 500 g.p.m.
(Make, type and size)
 (b) Motor 25 HP Electric - General Electric
(Type and horsepower)

14. Location of area irrigated or to be irrigated, or place of use if for purposes other than irrigation.

Township North or South	Range E. or W. of Willamette Meridian	Section	Forty-acre Tract	Number Acres To Be Irrigated	Date of Reclamation
T16S	R4W	4	NW, SW	7.97	October 1952
T16S	R4W	5	NE, SE	28.61	October 1952
T16S	R4W	5	NW, SE	13.58	October 1952
T16S	R4W	5	SW, SE	34.42	October 1952
T16S	R4W	5	SE, SE	35.50	October 1952
T16S	R4W	8	NE, NW	3.67	October 1952
T16S	R4W	8	NW, NE	11.57	October 1952
T16S	R4W	8	NE, NE	30.72	October 1952
T16S	R4W	8	SE, NE	32.30	October 1952
				<u>198.34</u>	

15. If the ground water supply is supplemental to an existing water supply, identification of any application for a permit, permit, certificate or adjudicated right to appropriate water made or held by the registrant.

Township 16S Range 4W, W.M.
North

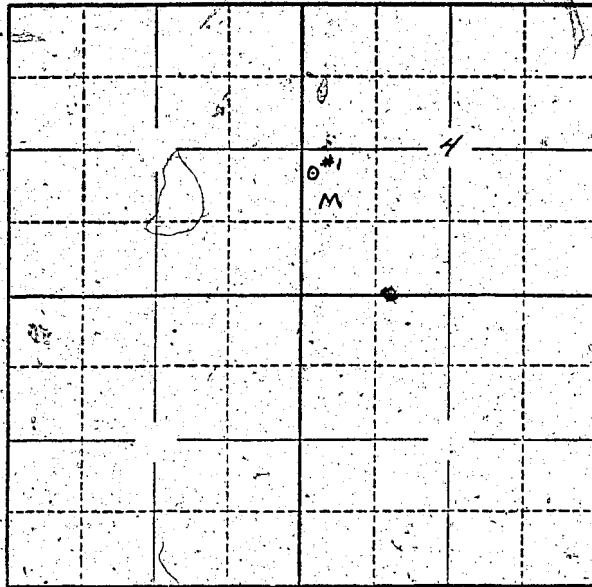

Locate well and acreage of irrigated land on plat.
Scale: 2" = 1 Mile

STATE OF OREGON

County of Linn } ss.

I, Carly J. Stone, being first duly sworn, do hereby certify that I have read the foregoing Registration Statement and that all of the items therein contained are true to the best of my knowledge and belief.

Carly J. Stone
(Signature of Registrant)

Subscribed and sworn to before me this 31st day of July, 1958.

My commission expires April 11, 1960

Edwin B. Swickard
(Notary Public)

(SEAL)

CERTIFICATE OF REGISTRATION

STATE OF OREGON

County of Marion } ss.

This is to certify that the foregoing Registration Statement was received in the office of the State Engineer on the 1st day of August, 1958, at 2:00 o'clock P.M. and has been duly recorded in said office in Book No. 14 of Registration Statements on page GR-3405

Witness my hand this 20th day of August, 1959

Laura A. Stanley
(State Engineer)

By _____ (Deputy)

\$ 30.45

GR. **3405**