

Registration Statement

OF CLAIMANT OF RIGHT TO APPROPRIATE GROUND WATER

TO THE STATE ENGINEER OF OREGON:

I, Carey L. Strome

of P. O. Box 548 Junction City, Oregon County of Lane

State of Oregon, do hereby make application for a certificate of registration as evidence of a right to appropriate ground water.

1. Source from which water is withdrawn is Driven Well
(Flowing well, pump well, infiltration trench, or tunnel)

2. Location is: 1 mi S. E. Junction City, Oregon
(Approximate distance and direction from nearest city or town)

and is more particularly described as follows:

(a) 3100" S27°50'E of the NW Corner of Section 4
(Give distance and bearing to corner of section or other legal subdivision)

being within NE, SW of Sec. 4, Twp. 16S Rge. R4W
(Smallest legal subdivision) (N. or S.) (E. or W.)

or (b) within limits of recorded platted property, town or city:

in Lot _____, Block _____ of _____
(Name of plat or addition)

County of _____
(If within city or town, give name)

3. Construction Work was begun on Oct. 15, 1952; was completed on Oct. 30, 1952
(Date) (Date)

and the ground water claimed was first used for the purposes set out below on November 1952
(Date)

since which time the water has been used Intermittently
(Continuously or intermittently)

from May to Sept.
(Date) (Date)

4. Quantity of water claimed and used is 500 gallons per minute; _____ acre feet per year.

5. Purpose or Purposes for which water is used Irrigation

(Domestic, irrigation, municipal, manufacturing, industrial, etc.)

6. Description of Well: Depth 30 feet. Type Driven
(Dug or drilled)

diameter 2-6" inches. Elevation of ground at well site _____ feet, mean sea level.
(As near as known)

Depth to water table 9 feet.

7. Capacity of Well: 750 g.p.m. with 3 feet drawdown.

_____ g.p.m. with _____ feet drawdown.


Date of test October 1952

If Flowing Well: Measured discharge _____ g.p.m. on _____
(Date)

Shut-in pressure at ground surface _____ lbs. per sq. in. on _____
(Date)

Water is controlled by _____
(Cap. valve, etc.)

Township 16 S Range 4 W W.M.
North

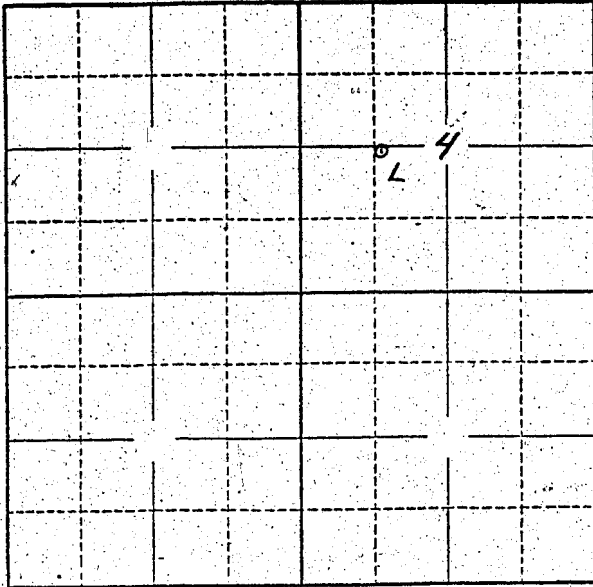

Locate well and acreage of irrigated land on plat.
Scale: 2" = 1 Mile

STATE OF OREGON

County of Lane } ss.

I, Carly J. Stone, being first duly sworn, do hereby certify that I have read the foregoing Registration Statement and that all of the items therein contained are true to the best of my knowledge and belief.

Carly J. Stone
(Signature of Registrant)

Subscribed and sworn to before me this 31st day of July, 1958.

My commission expires April 11, 1960

Robert S. Strickland
(Notary Public)

(SEAL)

CERTIFICATE OF REGISTRATION

STATE OF OREGON

County of Marion } ss.

This is to certify that the foregoing Registration Statement was received in the office of the State Engineer on the 1st day of August, 1957, at 2:00 o'clock A.M. and has been duly recorded in said office in Book No. 14 of Registration Statements on page GR 3407

Witness my hand this 20th day of August, 1959

Lewis A. Strickley
(State Engineer)

By _____ (Deputy)

\$ 30.15

GR - 3407