

# Registration Statement

## OF CLAIMANT OF RIGHT TO APPROPRIATE GROUND WATER

TO THE STATE ENGINEER OF OREGON:

I, Harvey Mitchell  
of Route 1, Jefferson, Oregon County of Linn  
(Mailing address)  
State of Oregon, do hereby make application for a certificate of registration as evidence of a right to appropriate ground water.

- 1. Source from which water is withdrawn is Pump well #2  
(Flowing well, pump well, infiltration trench, or tunnel)
- 2. Location is: 5 Miles South of Jefferson  
(Approximate distance and direction from nearest city or town)

and is more particularly described as follows:

- (a) 990 ft. N. 40° W. of E. 1/4 Corner of Sec. 24  
(Give distance and bearing to corner of section or other legal subdivision)  
being within SE 1/4 of NE 1/4 of Sec. 24, Twp. 10, Rge. 3W  
(Smallest legal subdivision) (Township) (Range)
- (b) within limits of recorded platted property, town or city: \_\_\_\_\_

Block \_\_\_\_\_ of \_\_\_\_\_  
(Name of plat or addition)  
County of Linn MARION  
(If within city or town, give name)

- 3. Construction Work was begun on 1952; was completed on 1952  
(Date) (Date)  
and the ground water claimed was first used for the purposes set out below on June 20  
(Date)  
since which time the water has been used intermittently  
(Continuously or Intermittently)  
from April to Sept.  
(Date) (Date)

4. Quantity of water claimed and used is 600 gallons per minute; \_\_\_\_\_ acre feet per year.

- 5. Purpose or Purposes for which water is used irrigation  
(Domestic, irrigation, municipal, manufacturing, industrial, etc.)

6. Description of Well: Depth 25 feet. Type drilled  
(Dug or drilled)  
diameter 10 inches. Elevation of ground at well site 226 feet, mean sea level.  
(As near as known)  
Depth to water table 10 feet.

- 7. Capacity of Well: 600 g.p.m. with 8 feet drawdown.  
\_\_\_\_\_ g.p.m. with \_\_\_\_\_ feet drawdown.

Date of test 7/30/58

If Flowing Well: Measured discharge \_\_\_\_\_ g.p.m. on \_\_\_\_\_  
(Date)

Shut-in pressure at ground surface \_\_\_\_\_ lbs. per sq. in. on \_\_\_\_\_  
(Date)

Water is controlled by \_\_\_\_\_  
(Cap, valve, etc.)

8. Casing: (Give diameter, commercial specifications and depth below ground surface of each casing size.)

..... inch diameter *unk* ..... from ..... to ..... feet  
..... inch diameter ..... from ..... to ..... feet  
..... inch diameter ..... from ..... to ..... feet  
..... inch diameter ..... from ..... to ..... feet

Describe and show depth of shoe, plug, adapter, liner or other details: .....

9. Perforated Casings or Screens:

*unk* ..... from ..... to .....  
(Number per foot and size of perforations, or describe screen)  
..... from ..... to .....  
..... from ..... to .....  
..... from ..... to .....

10. Log of Well: (Describe each stratum or formation clearly, indicate if water bearing, and give thickness and depth as indicated.)

MATERIAL	Thickness (Feet)	Depth to Bottom (Feet)
<i>Not available</i>		

If log of well is not available, give name and address of driller. Bill Hamilton

Albany Oregon

11. Infiltration Trench: Covered or open \_\_\_\_\_  
 Dimensions: Length \_\_\_\_\_ ft. Minimum depth \_\_\_\_\_ ft. Maximum depth \_\_\_\_\_ ft.  
 Bottom width \_\_\_\_\_ ft. Discharge \_\_\_\_\_ g.p.m. Date of test \_\_\_\_\_

12. Tunnel: Type of lining \_\_\_\_\_  
 Dimensions: \_\_\_\_\_  
 (Length, course, and cross sectional size)  
 Position of water bearing stratum with reference to portal of tunnel \_\_\_\_\_

Log of tunnel: (Preceding table for log of well may be used, if desired. Give footage from portal and character of materials, as pertinent.)


13. Pumping Equipment:  
 (a) Pump Saurbank - Morse Capacity \_\_\_\_\_ g.p.m.  
 (Make, type and size)  
 (b) Motor 2.0 horse Electric  
 (Type and horsepower)

14. Location of area irrigated or to be irrigated, or place of use if for purposes other than irrigation.

Township North or South	Range E. or W. of Willamette Meridian	Section	Forty-acre Tract	Number Acres To Be Irrigated	Date of Reclamation
T10S	R2W	19	NW 1/4 of the NW 1/4	25.0	1952
"	"	19	SW 1/4 of the NW 1/4	10.0	"
T10S	R3W	24	NE 1/4 of the NE 1/4	7.0	"
"	"	24	SE 1/4 of the NE 1/4	28.0	"
				<u>70.0</u>	

15. If the ground water supply is supplemental to an existing water supply, identification of any application for a permit, permit, certificate or adjudicated right to appropriate water made or held by the registrant.

Township 10s Range 3W, W.M.  
North

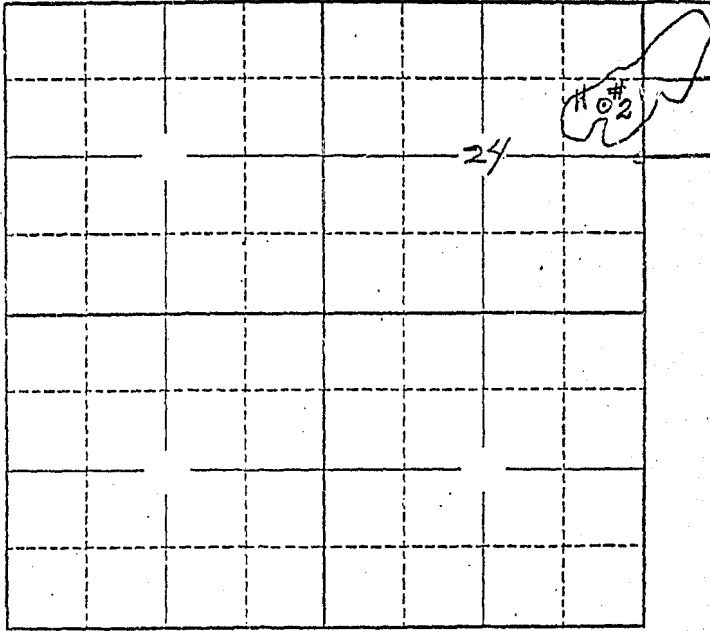

Locate well and acreage of irrigated land on plat.  
Scale: 2" = 1 Mile

STATE OF OREGON }  
County of Tillamook } ss.

I, Harvey Mitchell, being first duly sworn, do hereby certify that I have read the foregoing Registration Statement and that all of the items therein contained are true to the best of my knowledge and belief.

Harvey Mitchell  
(Signature of Registrant)

Subscribed and sworn to before me this 1 day of Aug, 1958

My commission expires My Commission Expires April 19, 1960

Frank B. Chittles  
(Notary Public)

(SEAL)

**CERTIFICATE OF REGISTRATION**

STATE OF OREGON }  
County of Marion } ss.

This is to certify that the foregoing Registration Statement was received in the office of the State Engineer on the 4th day of August, 1958, at 8:00 o'clock A.M. and has been duly recorded in said office in Book No. 17 of Registration Statements on page GR 4144

Witness my hand this 5th day of August, 1966.

Charles L. ...  
(State Engineer)

# 21.00

By \_\_\_\_\_  
(Deputy)

GR 4144