

# Registration Statement

## OF CLAIMANT OF RIGHT TO APPROPRIATE GROUND WATER

TO THE STATE ENGINEER OF OREGON:

I, Harvey Mitchell

of Route 1, Jefferson, Oregon County of Linn

State of Oregon, do hereby make application for a certificate of registration as evidence of a right to appropriate ground water.

1. Source from which water is withdrawn is Pump well # 5  
(Flowing well, pump well, infiltration trench, or tunnel)

2. Location is: 5 Miles South of Jefferson  
(Approximate distance and direction from nearest city or town)

and is more particularly described as follows:

(a) 1071' N 70° W of SE Section Cor  
(Give distance and bearing to corner of section or other legal subdivision)

lying within SE 1/4 of SE 1/4 of Sec. 24, Twp. 10S, Rge. 3W  
(Smallest legal subdivision) (S. or W.)

or (b) within limits of recorded platted property, town or city:

in Lot \_\_\_\_\_, Block \_\_\_\_\_ of \_\_\_\_\_  
(Name of plat or addition)

\_\_\_\_\_ County of \_\_\_\_\_  
(If within city or town, give name)

3. Construction Work was begun on 1948; was completed on 1948  
(Date) (Date)

and the ground water claimed was first used for the purposes set out below on June 22  
(Date)

since which time the water has been used intermittantly  
(Continuously or intermittently)

from April to Sept.  
(Date) (Date)

4. Quantity of water claimed and used is 800 gallons per minute; \_\_\_\_\_ acre feet per year.

5. Purpose or Purposes for which water is used irrigation

(Domestic, irrigation, municipal, manufacturing, industrial, etc.)

6. Description of Well: Depth 25 feet. Type drilled  
(Dug or drilled)

diameter 4 inches. Elevation of ground at well site 226 feet, mean sea level.  
(As near as known)

Depth to water table 5' feet.

7. Capacity of Well: 800 g.p.m. with 6 feet drawdown.

\_\_\_\_\_ g.p.m. with \_\_\_\_\_ feet drawdown.

Date of test 7/30/58

If Flowing Well: Measured discharge \_\_\_\_\_ g.p.m. on \_\_\_\_\_  
(Date)

Shut-in pressure at ground surface \_\_\_\_\_ lbs. per sq. in. on \_\_\_\_\_  
(Date)


Water is controlled by \_\_\_\_\_  
(Cap. valve, etc.)





Sec 24

Township 10S Range 3W, W.M. North

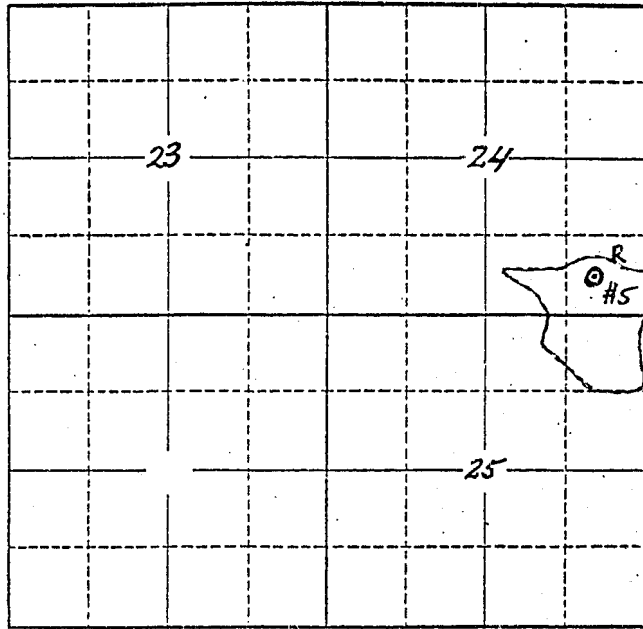

Locate well and acreage of irrigated land on plat.  
Scale: 2" = 1 Mile

STATE OF OREGON

County of Marion } ss.

I, Harvey Mitchell, being first duly sworn, do hereby certify that I have read the foregoing Registration Statement and that all of the items therein contained are true to the best of my knowledge and belief.

Harvey Mitchell  
(Signature of Registrant)

Subscribed and sworn to before me this 1 day of Aug, 1958

My commission expires NOTARY PUBLIC FOR OREGON  
My Commission Expires April 19, 1960

Low, B. C. Keith  
(Notary Public)

(SEAL)

CERTIFICATE OF REGISTRATION

STATE OF OREGON

County of Marion } ss.

This is to certify that the foregoing Registration Statement was received in the office of the State Engineer on the 4th day of August, 1958, at 8:00 o'clock A.M. and has been duly recorded in said office in Book No. 17 of Registration Statements on page GR-4146.

Witness my hand this 5th day of August, 1966

[Signature]  
(State Engineer)

\$ 25.50

By \_\_\_\_\_ (Deputy)

GR 4146