

Registration Statement

OF CLAIMANT OF RIGHT TO APPROPRIATE GROUND WATER

TO THE STATE ENGINEER OF OREGON:

I, Robert E. White

of Rt. 1 Box 245A Jefferson County of MARION
(Mailing address)

State of Oregon, do hereby make application for a certificate of registration as evidence of a right to appropriate ground water.

1. Source from which water is withdrawn is Well #1
(Flowing well, pump well, infiltration trench, or tunnel)

2. Location is: 1/2 Miles South of Jefferson Ave
(Approximate distance and direction from nearest city or town)

and is more particularly described as follows:

(a) 1455' N AND 3894' W OF SE CORNER S 13, T. 10S, R. 3W
(Give distance and bearing to corner of section or other legal subdivision)

being within NE 1/4 of Sec. 13 of Sec. 13, Twp. 10S, Rge. 3W
(Smallest legal subdivision) (N. or S.) (E. or W.)

or (b) within limits of recorded platted property, town or city:

in Lot _____, Block _____ of _____
(Name of plat or addition)

County of MARION
(If within city or town, give name)

3. Construction Work was begun on 1954; was completed on 1954
(Date) (Date)

and the ground water claimed was first used for the purposes set out below on 1954
(Date)

since which time the water has been used Continuously From Season
(Continuously or intermittently)

from 1954 to PRESENT TIME
(Date) (Date)

4. Quantity of water claimed and used is 0.75 gallons per minute; 87.0 acre feet per year.

5. Purpose or Purposes for which water is used irrigating

(Domestic, irrigation, municipal, manufacturing, industrial, etc.)

6. Description of Well: Depth 25 feet. Type Bored
(Dug or drilled)

diameter 8 inches. Elevation of ground at well site 220 feet, mean sea level.
(As near as known)

Depth to water table 10.1 feet.

7. Capacity of Well: 225 g.p.m. with 2 feet drawdown.

_____ g.p.m. with _____ feet drawdown.


Date of test Recently Not Tested

If Flowing Well: Measured discharge _____ g.p.m. on _____
(Date)

Shut-in pressure at ground surface _____ lbs. per sq. in. on _____
(Date)

Water is controlled by _____
(Cap, valve, etc.)

Township 10 S Range 9 W, W.M.
North

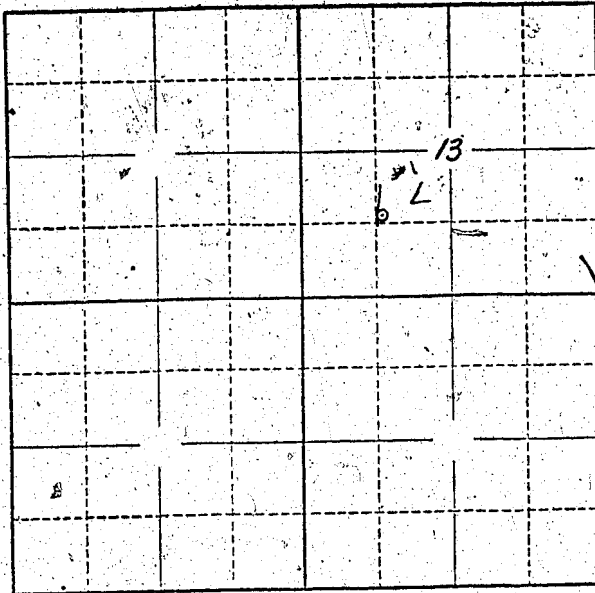

Locate well and acreage of irrigated land on plat.
Scale: 2" = 1 Mile

STATE OF OREGON

County of Linn } ss.

I, ROBERT E. WHITE, being first duly sworn, do hereby certify that I have read the foregoing Registration Statement and that all of the items therein contained are true to the best of my knowledge and belief.

Robert E. White
(Signature of Registrant)

Subscribed and sworn to before me this 1st day of August, 1958

My commission expires MY COMMISSION EXPIRES MAY 22, 1962

Lillian F. Phillips
(Notary Public)

(SEAL)

CERTIFICATE OF REGISTRATION

STATE OF OREGON

County of Marion } ss.

This is to certify that the foregoing Registration Statement was received in the office of the State Engineer on the 1st day of August, 1958, at 3:45 o'clock P.M. and has been duly recorded in said office in Book No. 14 of Registration Statements on page GR-3409

Witness my hand this 20th day of August, 1959

Alvin A. Stanley
(State Engineer)

By _____ (Deputy)

#16.35

GR. 3409