

#3 15.00

Registration No. GR. 3749

Certificate No. GR. 3411

Registration Statement

OF CLAIMANT OF RIGHT TO APPROPRIATE GROUND WATER

TO THE STATE ENGINEER OF OREGON:

I, Robert F. White
of Rt. 1 Box 245A Jefferson County Marion
State of Oregon do hereby make application for a certificate of registration as evidence of a right to appropriate ground water.

- 1. Source from which water is withdrawn is Well
(Flowing well, pump well, infiltration trench, or tunnel)
- 2. Location is: 1 1/2 Miles South of Jefferson
(Approximate distance and direction from nearest city or town)

and is more particularly described as follows:

(a) 198' S AND 326.2' W OF NE CORNER S. 24, T. 10S, R. 3W
(Give distance and bearing to corner of section or other legal subdivision)
being within NE 1/4 NW 1/4 of Sec. 24, Twp. 10S, Rge. 3W
(Smallest legal subdivision) (N. or S.) (E. or W.)
or (b) within limits of recorded platted property, town or city:
in Lot _____, Block _____ of _____
(Name of plat or addition)

County of MARION
(If within city or town, give name)

3. Construction Work was begun on 4/22/1954; was completed on 6/26/1954
(Date) (Date)
and the ground water claimed was first used for the purposes set out below on 1954
(Date)
since which time the water has been used Continuously
(Continuously or intermittently)
from 1954 to Present
(Date) (Date)

4. Quantity of water claimed and used is 150 gallons per minute; 2.9 acre feet per year.

5. Purpose or Purposes for which water is used Irrigation
(Domestic, irrigation, municipal, manufacturing, industrial, etc.)

6. Description of Well: Depth 23 1/2 feet. Type Drilled
(Dug or drilled)
diameter 10 inches. Elevation of ground at well site 220 feet, mean sea level.
(As near as known)
Depth to water table 6 feet.

7. Capacity of Well: _____ g.p.m. with _____ feet drawdown.
_____ g.p.m. with _____ feet drawdown.

Date of test Not Tested

If Flowing Well: Measured discharge _____ g.p.m. on _____
(Date)

Shut-in pressure at ground surface _____ lbs. per sq. in. on _____
(Date)

Water is controlled by _____
(Cap, valve, etc.)

8. Casing: (Give diameter, commercial specifications and depth below ground surface of each casing size.)

10 inch diameter STEEL CASING from 0 to 13.5 feet
 _____ inch diameter _____ from _____ to _____ feet
 _____ inch diameter _____ from _____ to _____ feet
 _____ inch diameter _____ from _____ to _____ feet

Describe and show depth of shoe, plug, adapter, liner or other details: _____

9. Perforated Casings or Screens:

SLOT PERFORATIONS from 13 to 23.5
(Number per foot and size of perforations, or describe screen)
 _____ from _____ to _____
 _____ from _____ to _____
 _____ from _____ to _____

10. Log of Well: (Describe each stratum or formation clearly, indicate if water bearing, and give thickness and depth as indicated.)

MATERIAL	Thickness (Feet)	Depth to Bottom (Feet)
NAT AQUICLUD		

If log of well is not available, give name and address of driller: Bill Hamilton

ALBANY, ORE

11. Infiltration Trench: Covered or open _____

Dimensions: Length _____ ft. Minimum depth _____ ft. Maximum depth _____ ft.

Bottom width _____ ft. Discharge _____ g.p.m. Date of test _____

12. Tunnel: Type of lining _____

Dimensions: _____
(Length, course, and cross sectional size)

Position of water bearing stratum with reference to portal of tunnel _____

Log of tunnel: (Preceding table for log of well may be used, if desired. Give footage from portal and character of materials, as pertinent.)

13. Pumping Equipment:

(a) Pump Alice Chalmers 2" X 3" Cast Iron Capacity 200 g.p.m.
(Make, type and size)


(b) Motor Alice Chalmers 10 HP
(Type and horsepower)

14. Location of area irrigated or to be irrigated, or place of use if for purposes other than irrigation.

Township North or South	Range E. or W. of Willamette Meridian	Section	Forty-acre Tract	Number Acres To Be Irrigated	Date of Reclamation
<u>10 S.</u>	<u>3 W.</u>	<u>24</u>	<u>NE 1/4 of NW 1/4</u>	<u>7.25</u>	<u>1954</u>
<u>10 S.</u>	<u>3 W.</u>	<u>24</u>	<u>NW 1/4 of NE 1/4</u>	<u>2.75</u>	<u>"</u>
				<u>10.00</u>	

15. If the ground water supply is supplemental to an existing water supply, identification of any application for a permit, permit, certificate or adjudicated right to appropriate water made or held by the registrant.

Township 10 S Range 26 W W.M.
North

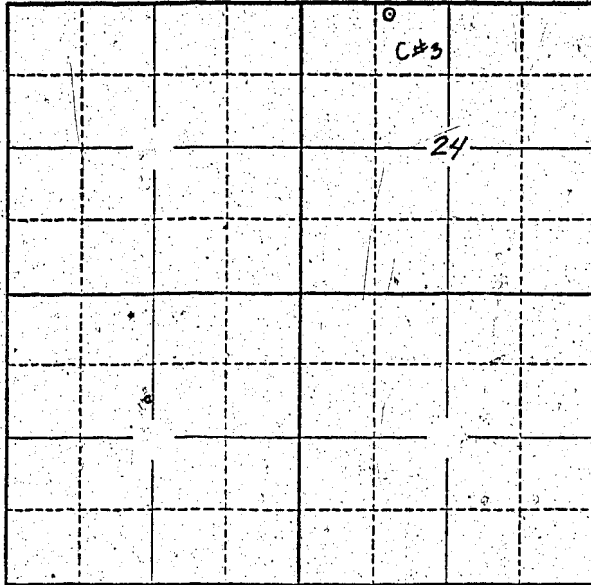

Locate well and acreage of irrigated land on plat.
Scale: 2" = 1 Mile

STATE OF OREGON

County of Linn } ss.

I, ROBERT E. WHITE, being first duly sworn, do hereby certify that I have read the foregoing Registration Statement and that all of the items therein contained are true to the best of my knowledge and belief.

[Signature]
(Signature of Registrant)

Subscribed and sworn to before me this 1st day of June, 1958

My commission expires MY COMMISSION EXPIRES MAY 22, 1962

[Signature]
(Notary Public)

(SEAL)

CERTIFICATE OF REGISTRATION

STATE OF OREGON

County of Marion } ss.

This is to certify that the foregoing Registration Statement was received in the office of the State Engineer on the 1st day of August, 1958, at 3:45 o'clock P. M. and has been duly recorded in said office in Book No. 14 of Registration Statements on page GR-3411

Witness my hand this 20th day of August, 1959

[Signature]
(State Engineer)

By _____ (Deputy)

\$15.00

GR 3411