

**RECEIVED**

REGISTRATION NO. GR-325

FEB 18 1957.  
STATE ENGINEER  
SALEM, OREGON

Registration Statement CERTIFICATE NO. BR 361

**OF CLAIMANT OF RIGHT TO APPROPRIATE GROUND WATER**

(Under Chapter 708, Oregon Laws 1955.)

**TO THE STATE ENGINEER OF OREGON:**

I, Charles G. and Henry P. Lacer

of Rt. 2, Box 211, Lebanon County of Linn

State of \_\_\_\_\_, do hereby make application for a certificate of registration as evidence of a right to appropriate ground water.

1. Source from which water is withdrawn is pump well

(Flowing well, pump well, infiltration trench, or tunnel)

2. Location is: 5 miles north of Lebanon, Oregon

(Approximate distance and direction from nearest city or town)

and is more particularly described as follows:

(a) N. 4° 20' W. 33 chains from the SW corner of SE<sup>1/4</sup> of S. 23, T. 11 S., R. 2 W.  
(Give distance and bearing to corner of section or other legal subdivision)

being within NE<sup>1/4</sup> of SW<sup>1/4</sup> of Sec. 23, Twp. 11 S., Rge. 2 W.  
(Smallest legal subdivision N. or S. E. or W.)

or (b) within limits of recorded platted property, town or city:

in Lot \_\_\_\_\_, Block \_\_\_\_\_ of \_\_\_\_\_  
(Name of plat or addition)

County of Linn  
(If within city or town, give name)

3. Construction Work was begun on Sept. 14, 1953; was completed on Sept. 16, 1953  
(Date) (Date)

and the ground water claimed was first used for the purposes set out below on May 25, 1954  
(Date)

since which time the water has been used continuously  
(Continuously or intermittently)

from May 25, 1954 to present time  
(Date) (Date)

4. Quantity of water claimed and used is 300 gallons per minute; 152.5 acre feet per year.

5. Purpose or Purposes for which water is used Irrigation

(Domestic, irrigation, municipal, manufacturing, industrial, etc.)

6. Description of Well: Depth 25 feet. Type Drilled  
(Dug or drilled)

diameter 8 inches. Elevation of ground at well site 292 feet, mean sea level.  
(As near as known)

Depth to water table 12' feet.

7. Capacity of Well: 300 g.p.m. with 3 feet drawdown.

g.p.m. with \_\_\_\_\_ feet drawdown.

Date of test Not tested

If Flowing Well: Measured discharge \_\_\_\_\_ g.p.m. on \_\_\_\_\_  
(Date)

Shut-in pressure at ground surface \_\_\_\_\_ lbs. per sq. in. on \_\_\_\_\_  
(Date)

Water is controlled by \_\_\_\_\_  
(Cap, valve, etc.)

**8. Casing:** (Give diameter, commercial specifications and depth below ground surface of each casing size.)

8 inch diameter steel casing from 0 to 25 feet  
 inch diameter from to feet  
 inch diameter from to feet  
 inch diameter from to feet

Describe and show depth of shoe, plug, adapter, liner or other details:

**9. Perforated Casings or Screens:**

Slit perforations from 20 to 25.

(Number per foot and size of perforations, or describe screen)

from to  
 from to  
 from to  
 from to

from to

**10. Log of Well:** (Describe each stratum or formation clearly, indicate if water bearing, and give thickness and depth as indicated.)

MATERIAL	Thickness (Feet)	Depth to Bottom (Feet)
Not available		

Beginning at a point which is 29.23 chains East and 22.36 chains North of a point where the West boundary line of Sec. 23 in T. 11 S., R. 2 W. of the Will. M-r., Oregon, crosses the North boundary of the D.L.C. of Edward Abbott and wife, Not. No. 1192, Claim No. 56 old mill race; thence North 12.48 chains, thence East to the center of an to the head of said mill race; thence North 10 chains; thence East to the South Sagtai River; thence up said river to a point due East of the place of beginning; thence West to the place of beginning; ALSO,

Beginning at a point on the North boundary line of the D.L.C. of Edward Abbott and wife, Not. No. 1192, Claim No. 56, in T. 11 S., R. 2 W. of the Will. M-r., Oregon, where the East line of Sec. 23, in said T. and R., intersects the North line of said Claim No. 56, and running thence West 33.27 chains; thence North 22.86 chains to the Northeast corner of Wallace's land; thence East 33.27 chains, more or less, to the East boundary line of said Sec. 23; thence South 22.36 chains to the place of beginning; ALSO,

Beginning at the North boundary line of the D.L.C. of Edward Abbott and wife, Not. no. 1192, Claim No. 56, in T. 11 S., R. 4 W. of the Will. M-r., Oregon, and 29.23 chains East of the West line of Sec. 23, in said T. and R., and running thence East 17.50 chains; thence North 22.36 chains; thence West 17.50 chains; thence South 22.86 chains to the place of beginning; containing in the aggregate 136 acres, more or less, and all situated in Linn County, Oregon.

76-409 Ex.

Beginning at a point which is East 29.23 chains distant and North 30.54 chains distant from the point where the West boundary line of Section 23 in t. 11 S., R. 2 W. of the Will. M-r. wife, Not. No. 1192 and Claim No. 56 in said T. and R., and from said point of beginning running thence East 11.55 chains to the center of an old mill race, thence following down the center of said mill race as follows, N. 57°W. 1.69 1/2 chains, N. 66°26'W. 3.87 chains, N. 73°15'W. 3.12 chains, N. 48°30'W. 4.10 chains, thence running West 50 links to a point due North of the place of beginning, thence South 4.80 chains to the place of beginning and containing 2.10 acres, more or less. All the land hereby conveyed being in Linn County, State of Oregon.

If log of well is not available, give name and address of driller. Not known

11. Infiltration Trench: Covered or open \_\_\_\_\_

Dimensions: Length ..... ft. Minimum depth ..... ft. Maximum depth ..... ft.

Bottom width ..... ft. Discharge ..... g.p.m. Date of test \_\_\_\_\_

12. Tunnel: Type of lining \_\_\_\_\_

Dimensions: \_\_\_\_\_  
(Length, course, and cross sectional size)

Position of water bearing stratum with reference to portal of tunnel \_\_\_\_\_

Log of tunnel: (Preceding table for log of well may be used, if desired. Give footage from portal and character of materials, as pertinent.)

13. Pumping Equipment:

(a) Pump Gould 3" Centrifugal Capacity 300 g.p.m.  
(Make, type and size)

(b) Motor 15 H. P. electric (Type and horsepower)


14. Location of area irrigated or to be irrigated, or place of use if for purposes other than irrigation.

Township North or South	Range E. or W. of Willamette Meridian	Section	Forty-acre Tract	Number Acres To Be Irrigated	Date of Reclamation
11 S	2 W	23	$SW\frac{1}{4}$ of $NE\frac{1}{4}$	6.4	May 25, 1954
11 S	2 W	23	$SE\frac{1}{4}$ of $NW\frac{1}{4}$	9.6	May 25, 1954
11 S	2 W	23	$NE\frac{1}{4}$ of $SW\frac{1}{4}$	20.3	May 25, 1954
11 S	2 W	23	$SE\frac{1}{4}$ of $SW\frac{1}{4}$	1.4	May 25, 1954
11 S	2 W	23	$NW\frac{1}{4}$ of $SE\frac{1}{4}$	21.3	May 25, 1954
11 S	2 W	23	$SW\frac{1}{4}$ of $SE\frac{1}{4}$	<u>2.0</u>	May 25, 1954
				61.0	

15. If the ground water supply is supplemental to an existing water supply, identification of any application for a permit, permit, certificate or adjudicated right to appropriate water made or held by the registrant.

Township 11S Range 2W W.M.

North

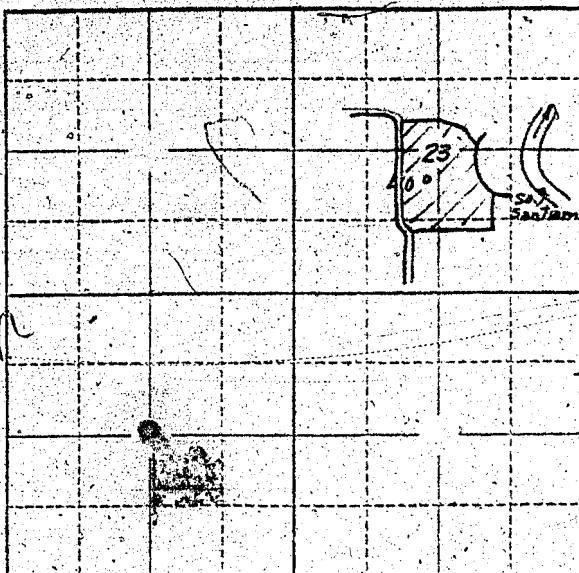

Locate well and acreage of irrigated land on plat.

Scale: 2" — 1 Mile

STATE OF OREGON

County of Linn } ss.

I, Charles G. & Henry P. Lacer, being first duly sworn, do hereby certify that I have read the foregoing Registration Statement and that all of the items therein contained are true to the best of my knowledge and belief.

Charles G. Lacer

Henry P. Lacer

(Signature of Registrant)

Subscribed and sworn to before me this 14 day of February, 1957.

My commission expires:

(SEAL)

A. M. Russell  
Linn County Clerk

#### CERTIFICATE OF REGISTRATION

STATE OF OREGON

{ ss.

County of Marion

This is to certify that the foregoing Registration Statement was received in the office of the State Engineer on the 18th day of February, 1957, at 8:00 o'clock A.M. and has been duly recorded in said office in Book No. 3 of Registration Statements on page GR-361 C.

Construction shall be completed by 1958 and the return inspection date is 1959.

Witness my hand this 30th day of April,

1957.

Lewis A. Shultz

(State Engineer)

\$19.65

By

(Deputy)

361 C