

Registration Statement

OF CLAIMANT OF RIGHT TO APPROPRIATE GROUND WATER

TO THE STATE ENGINEER OF OREGON:

MRS. Fred Padish
of 6630 Lake Salish Road, Salem, Oregon County of Marion
(Mailing address)

State of Oregon do hereby make application for a certificate of registration as evidence of a right to appropriate ground water.

1. Source from which water is withdrawn is Pump Well
(Flowing well, pump well, infiltration trench, or tunnel)

2. Location is: 7 miles North East of Salem
(Approximate distance and direction from nearest city or town)

and is more particularly described as follows:

(a) Well is East 1895.00' and South 705.00' from N.W. corner Sec. 32
(Give distance and bearing to corner of section or other legal subdivision)

being within N.E. 1/4 of N.W. 1/4 of Sec. 32, Twp. 6 S, Rge. 2 E
(Smallest legal subdivision) (N. or S.) (E. or W.)

or (b) within limits of recorded platted property, town or city: Suburban Garden

in Lot 111, Block of Suburban Garden
(Name of plat or addition)

County of Marion
(If within city or town, give name)

3. Construction Work was begun on 1945; was completed on 1945
(Date) (Date)

and the ground water claimed was first used for the purposes set out below on April 1945
(Date)

since which time the water has been used Intermittently
(Continuously or intermittently)

from 1946 to 1958
(Date) (Date)

4. Quantity of water claimed and used is 50 gallons per minute; 12.76 acre feet per year.

5. Purpose or Purposes for which water is used Irrigation
(Domestic, irrigation, municipal, manufacturing, industrial, etc.)

6. Description of Well: Depth 20 feet. Type drilled
(Dug or drilled)

diameter 8 inches. Elevation of ground at well site 20 feet, mean sea level.
(As near as known)

Depth to water table 55 feet.

7. Capacity of Well: _____ g.p.m. with _____ feet drawdown.

_____ g.p.m. with _____ feet drawdown.


Date of test _____

If Flowing Well: Measured discharge _____ g.p.m. on _____
(Date)

Shut-in pressure at ground surface _____ lbs. per sq. in. on _____
(Date)

Water is controlled by _____
(Cap, valve, etc.)

Township 6 S Range 2 W W.M.
North

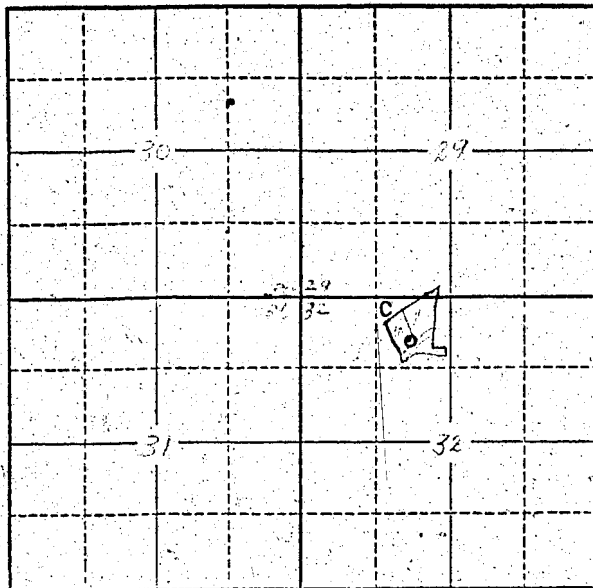

Locate well and acreage of irrigated land on plat.
Scale: 2" = 1 Mile

STATE OF OREGON

County of Marion } ss.

I, Mrs. Fred Paehl, being first duly sworn, do hereby certify that I have read the foregoing Registration Statement and that all of the items therein contained are true to the best of my knowledge and belief.

Mrs. Fred Paehl
(Signature of Registrant)

Subscribed and sworn to before me this 1st day of August, 1958

My commission expires 12th June 1961 Wm. S. Bartholomew
(Notary Public)

(SEAL)

CERTIFICATE OF REGISTRATION

STATE OF OREGON

County of Marion } ss.

This is to certify that the foregoing Registration Statement was received in the office of the State Engineer on the 1st day of August, 1958, at 3:55 o'clock P. M. and has been duly recorded in said office in Book No. 14 of Registration Statements on page GR-3413

Witness my hand this 20th day of August, 1959

Lucretia A. Stanley
(State Engineer)

By _____
(Deputy)

GR 3413

\$15.00