

Registration Statement

OF CLAIMANT OF RIGHT TO APPROPRIATE GROUND WATER

TO THE STATE ENGINEER OF OREGON:

I, H.G. McElroy (Atracia Ranch)
of Star Rt Aalseg County of Benton
(Mailing address)

State of Oregon, do hereby make application for a certificate of registration as evidence of a right to appropriate ground water.

1. Source from which water is withdrawn is Flowing Well
(Flowing well, pump well, infiltration trench, or tunnel)
2. Location is: 4 miles of Aalseg adjacent to Aalseg Highway
(Approximate distance and direction from nearest city or town)

and is more particularly described as follows:

(a) 32.5 ch N and 28 ch E from SW cor Sec 8
(Give distance and bearing to corner of section or other legal subdivision)

being within N 1/4 SW 1/4 of Sec. 8, Twp. 14S, Rge. 8W
(Smallest legal subdivision) (N. or S.) (E. or W.)

or (b) within limits of recorded platted property, town or city:

in Lot _____, Block _____ of _____
(Name of plat or addition)
County of _____
(If within city or town, give name)

3. Construction Work was begun on 1955; was completed on 1955
(Date) (Date)

and the ground water claimed was first used for the purposes set out below on 1955
(Date)

since which time the water has been used intermittently
(Continuously or intermittently)
from 1955 to 1958
(Date) (Date)

4. Quantity of water claimed and used is 30 gallons per minute; 8 acre feet per year.

5. Purpose or Purposes for which water is used irrigation

6. Description of Well: (Domestic, irrigation, municipal, manufacturing, industrial, etc.)
Depth 33" in diameter 42" deep feet. Type Dug
(Dug or drilled)
diameter _____ inches. Elevation of ground at well site 251 feet, mean sea level.
(As near as known)
Depth to water table 4 feet.

7. Capacity of Well: 30" 40 g.p.m. with 4" feet drawdown.
_____ g.p.m. with _____ feet drawdown.

Date of test _____

If Flowing Well: Measured discharge 120 g.p.m. on _____
(Date)

Shut-in pressure at ground surface _____ lbs. per sq. in. on _____
(Date)

Water is controlled by not controlled
(Cap, valve, etc.)

8. Casing: (Give diameter, commercial specifications and depth below ground surface of each casing size.)

..... inch diameter from to feet
 inch diameter from to feet
 inch diameter from to feet
 inch diameter from to feet

Describe and show depth of shoe, plug, adapter, liner or other details:

.....

.....


9. Perforated Casings or Screens:

..... from to
 (Number per foot and size of perforations, or describe screen)
 from to
 from to
 from to

10. Log of Well: (Describe each stratum or formation clearly, indicate if water bearing, and give thickness and depth as indicated.)

MATERIAL	Thickness (Feet)	Depth to Bottom (Feet)

Township 14S Range 8W, W.M. North

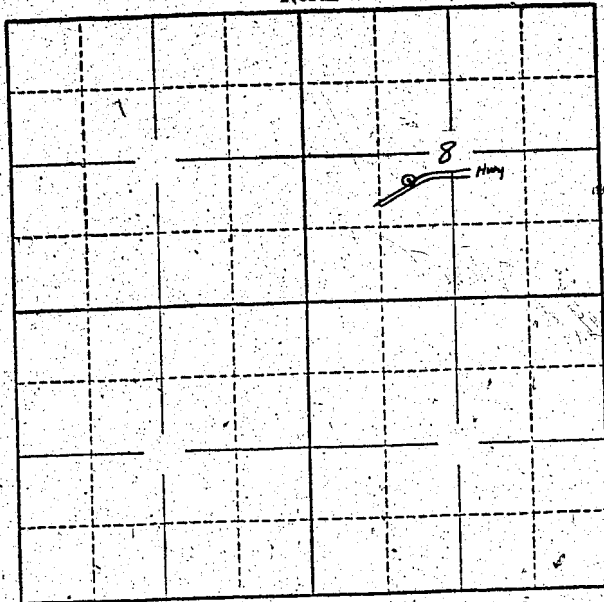

Locate well and acreage of irrigated land on plat.

Scale: 2" = 1 Mile

STATE OF OREGON

County of Benton } ss.

I, Mrs. H.G. McCloy, being first duly sworn, do hereby certify that I have read the foregoing Registration Statement and that all of the items therein contained are true to the best of my knowledge and belief.

Mrs. H.G. McCloy
(Signature of Registrant)

Subscribed and sworn to before me this 31st day of July, 1958

My commission expires Feb. 14, 1961

E. D. Bailey
(Notary Public)

(SEAL)

CERTIFICATE OF REGISTRATION

STATE OF OREGON

County of Marion } ss.

This is to certify that the foregoing Registration Statement was received in the office of the State Engineer on the 1st day of August, 1958, at 8:00 o'clock A. M. and has been duly recorded in said office in Book No. 14 of Registration Statements on page GR-3414

Witness my hand this 20th day of August, 1959

Laura A. Stanley
(State Engineer)

By _____ (Deputy)

15.00

GR 3414