


Township 11S Range 5W, W.M.
North

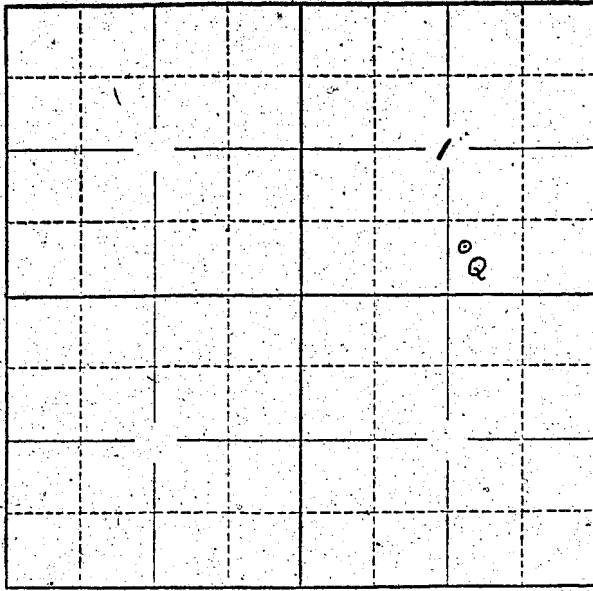

Locate well and acreage of irrigated land on plat.
Scale: 2" = 1 Mile

STATE OF OREGON

County of Benton } ss.

I, Alice L. [unclear], being first duly sworn, do hereby certify that I have read the foregoing Registration Statement and that all of the items therein contained are true to the best of my knowledge and belief.

Alice L. [unclear]
(Signature of Registrant)

Subscribed and sworn to before me this 31st day of July, 1958

My commission expires Feb 14 1961 E. H. [unclear]
(Notary Public)

(SEAL)

CERTIFICATE OF REGISTRATION

STATE OF OREGON

County of Marion } ss.

This is to certify that the foregoing Registration Statement was received in the office of the State Engineer on the 1st day of August, 1958, at 2:00 o'clock A.M. and has been duly recorded in said office in Book No. 14 of Registration Statements on page GR-3415

Witness my hand this 20th day of August, 1959

Laura J. Stanley
(State Engineer)

By _____ (Deputy)

\$15.00

GR. 3415