

Registration No. GR 3755

Certificate No. GR 3960

# Registration Statement

RECEIVED  
STATE ENGINEER  
SALEM, OREGON

## OF CLAIMANT OF RIGHT TO APPROPRIATE GROUND WATER

TO THE STATE ENGINEER OF OREGON:

I, MR. AND MRS. STIRNEMANN LOUIS

of Box 27 RR #2 GELLATLY WAY PHILOMATH County of BENTON

State of OREGON, do hereby make application for a certificate of registration as evidence of a right to appropriate ground water:

1. Source from which water is withdrawn is PUMP WELL  
(Flowing well, pump well, infiltration trench, or tunnel)
2. Location is: 2 MILES WEST PHILOMATH  
(Approximate distance and direction from nearest city or town)

and is more particularly described as follows:

(a) 110' South and 247' West of NE Cor. J.L. Bounds DLC #69  
(Give distance and bearing to corner of section or other legal subdivision)

being within NW 1/4 NE 1/4 of Sec. 15, Twp. 12 S, Rge. 6 W  
(Smallest legal subdivision) (N. or S.) (E. or W.)

or (b) within limits of recorded platted property, town or city:

in Lot \_\_\_\_\_, Block \_\_\_\_\_ of \_\_\_\_\_  
(Name of plat or addition)

County of \_\_\_\_\_

(If within city or town, give name)

3. Construction Work was begun on Aug. 7 1947; was completed on Aug. 8 1947  
(Date) (Date)

and the ground water claimed was first used for the purposes set out below on Aug. 14 1947  
(Date)

since which time the water has been used Continuously  
(Continuously or intermittently)

from Aug 14 1947 to 1958  
(Date) (Date)

4. Quantity of water claimed and used is No data gallons per minute; \_\_\_\_\_ acre feet per year.

5. Purpose or Purposes for which water is used IRRIGATION

(Domestic, irrigation, municipal, manufacturing, industrial, etc.)

6. Description of Well: Depth 50 feet. Type DRILLED

diameter 6 inches. Elevation of ground at well site 339 feet, mean sea level.  
(As near as known)

Depth to water table 27 feet.

7. Capacity of Well: No data g.p.m. with \_\_\_\_\_ feet drawdown.

\_\_\_\_\_ g.p.m. with \_\_\_\_\_ feet drawdown.

Date of test \_\_\_\_\_

If Flowing Well: Measured discharge \_\_\_\_\_ g.p.m. on \_\_\_\_\_  
(Date)


Shut-in pressure at ground surface \_\_\_\_\_ lbs. per sq. in. on \_\_\_\_\_  
(Date)

Water is controlled by \_\_\_\_\_  
(Cap. valve, etc.)





Township 125 Range 6W W.M.  
North

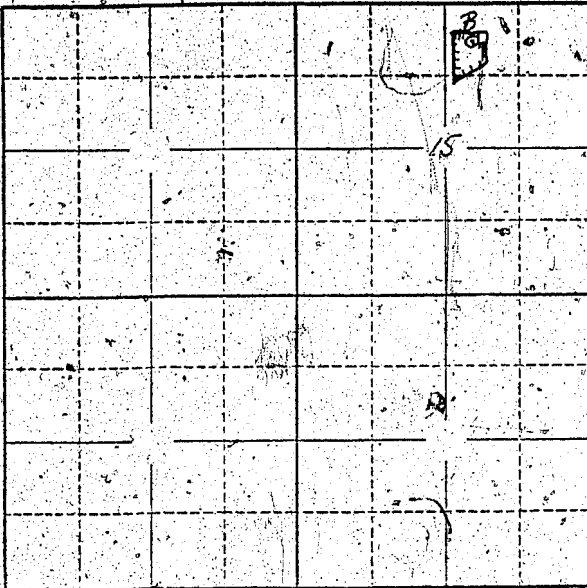

Locate well and acreage of irrigated land on plat.  
Scale: 2" = 1 Mile

STATE OF OREGON

County of Beatin } ss.

I Mrs. Louis Sturman, being first duly sworn, do hereby certify that I have read the foregoing Registration Statement and that all of the items therein contained are true to the best of my knowledge and belief.

Mrs. Louis Sturman  
Mrs. Louis Sturman  
(Signature of Registrant)

Subscribed and sworn to before me this 31 day of July, 1958.

My commission expires 10 FOR OREGON

Edward D. Gault  
(Notary Public)

(SEAL)

CERTIFICATE OF REGISTRATION

STATE OF OREGON

County of Marion } ss.

This is to certify that the foregoing Registration Statement was received in the office of the State Engineer on the 15<sup>th</sup> day of August, 1958, at 1:00 o'clock P.M. and has been duly recorded in said office in Book No. 16 of Registration Statements on page GR-3960

Witness my hand this 15<sup>th</sup> day of February, 1960

George A. Stanley  
(State Engineer)

By \_\_\_\_\_ (Deputy)

GR 3960