

RECEIVED  
AUG 1 1958  
STATE ENGINEER  
SALEM, OREGON

Registration No. GR. 3256

Certificate No. GR. 3416

# Registration Statement

## OF CLAIMANT OF RIGHT TO APPROPRIATE GROUND WATER

TO THE STATE ENGINEER OF OREGON:

I, Robert E Reinman

of 3901 Country Club Way, Corvallis County of Butler

State of Oregon, do hereby make application for a certificate of registration as evidence of a right to appropriate ground water.

1. Source from which water is withdrawn is  pump Well

2. Location is:  3 miles SW of Corvallis

and is more particularly described as follows:

(a)  40' North + 132' West of S.E. Cor. To AG Hedley DLC #43

being within  SE 1/4 SW 1/4  of Sec.  4 , Twp.  12S , Rge.  5W

or (b) within limits of recorded platted property, town or city:

in Lot \_\_\_\_\_, Block \_\_\_\_\_ of \_\_\_\_\_

County of \_\_\_\_\_

3. Construction Work was begun on  No Data   <sup>Prior to 1950</sup> ; was completed on  No Data

and the ground water claimed was first used for the purposes set out below on  No Data  1950

since which time the water has been used  Continuously

from  1950  to  1958

4. Quantity of water claimed and used is  40  gallons per minute;  20  acre feet per year.

5. Purpose or Purposes for which water is used  exempt Domestic + Irrigation

6. Description of Well: Depth  46  feet. Type  Drilled

diameter  6  inches. Elevation of ground at well site  740  feet, mean sea level.

Depth to water table  Not known  feet.

7. Capacity of Well:  60  g.p.m. with  Not known  feet drawdown.

Date of test \_\_\_\_\_

If Flowing Well: Measured discharge \_\_\_\_\_ g.p.m. on \_\_\_\_\_


Shut-in pressure at ground surface \_\_\_\_\_ lbs. per sq. in. on \_\_\_\_\_

Water is controlled by \_\_\_\_\_





Township 12.5, Range 5N, W.M.  
North

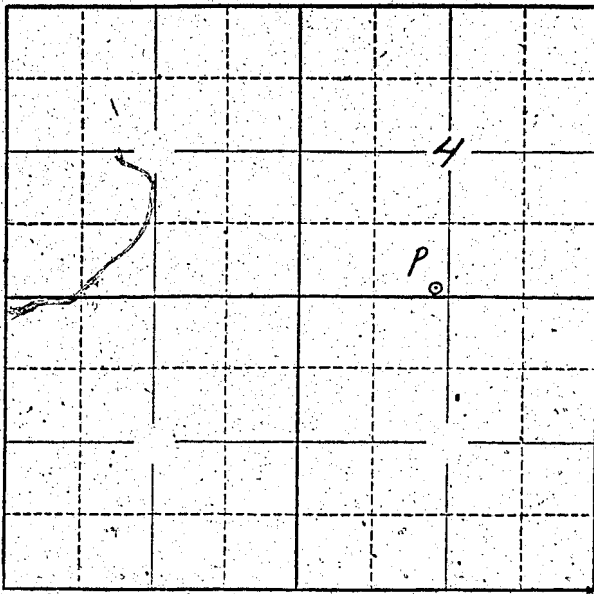

Locate well and acreage of irrigated land on plat.  
Scale: 2" = 1 Mile

STATE OF OREGON

County of \_\_\_\_\_

} ss.

I, Rebecca E. Reiman, being first duly sworn, do hereby certify that I have read the foregoing Registration Statement and that all of the items therein contained are true to the best of my knowledge and belief.

Rebecca E. Reiman  
(Signature of Registrant)

Subscribed and sworn to before me this 3/5 day of July, 1958

My commission expires 1/4/58

Scott Williams  
(Notary Public)

(SEAL)

**CERTIFICATE OF REGISTRATION**

STATE OF OREGON

County of Marion

} ss.

This is to certify that the foregoing Registration Statement was received in the office of the State Engineer on the 1<sup>st</sup> day of July, 1958, at 1:00 o'clock A. M. and has been duly recorded in said office in Book No. 14 of Registration Statements on page GR-3416

Witness my hand this 20<sup>th</sup> day of August, 1959

Lewis A. Stanley  
(State Engineer)

By \_\_\_\_\_

(Deputy)

1/50

GR 3416