

RECEIVED
MAY 1 1958
STATE ENGINEER
SALEM, OREGON

Registration Statement

OF CLAIMANT OF RIGHT TO APPROPRIATE GROUND WATER

TO THE STATE ENGINEER OF OREGON:

I, MAXINE ARNOLD THOMAS
3620 PALOMATH ROAD, CORVALLIS County of BENTON
(Mailing address)

State of OREGON do hereby make application for a certificate of registration as evidence of a right to appropriate ground water.

- 1. Source from which water is withdrawn is PUMP WELL
(Flowing well, pump well, infiltration trench, or tunnel)
- 2. Location is: 1/2 MILE WEST OF CORVALLIS
(Approximate distance and direction from nearest city or town)

and is more particularly described as follows:

(a) 160 FEET SOUTH AND 828 FEET WEST
PRIOR SCOTT DLC #44 (Give distance and bearing to corner of section of other legal subdivision)
being within SE 1/4 NE 1/4 of Sec. 4, Twp. 17 S, Rge. 5 W
(Smallest legal subdivision) (N. or S.) (E. or W.)

or (b) within limits of recorded platted property, town or city:

in Lot _____ Block _____ of _____
(Name of plat or addition)
County of BENTON
(If within city or town, give name)

3. Construction Work was begun on 1950; was completed on 1950
(Date) (Date)

and the ground water claimed was first used for the purposes set out below on 1950
(Date)

since which time the water has been used INTERMITTENTLY
(Continuously or intermittently)
from 1950 to 1958
(Date) (Date)

4. Quantity of water claimed and used is 25 gallons per minute; 7.2 acre feet per year.

5. Purpose or Purposes for which water is used IRRIGATION

(Domestic, irrigation, municipal, manufacturing, industrial, etc.)

6. Description of Well: Depth 58 feet. Type DRILLED
(Dug or drilled)

diameter 6 inches. Elevation of ground at well site _____ feet, mean sea level.
(As near as known)

Depth to water table 14 feet.

7. Capacity of Well: 30 g.p.m. with 6 feet drawdown.

_____ g.p.m. with _____ feet drawdown.


Date of test 1950

If Flowing Well: Measured discharge _____ g.p.m. on _____
(Date)

Shut-in pressure at ground surface _____ lbs. per sq. in. on _____
(Date)

Water is controlled by _____
(Cap, valve, etc.)

Township 12S Range 5W, W.M.
North

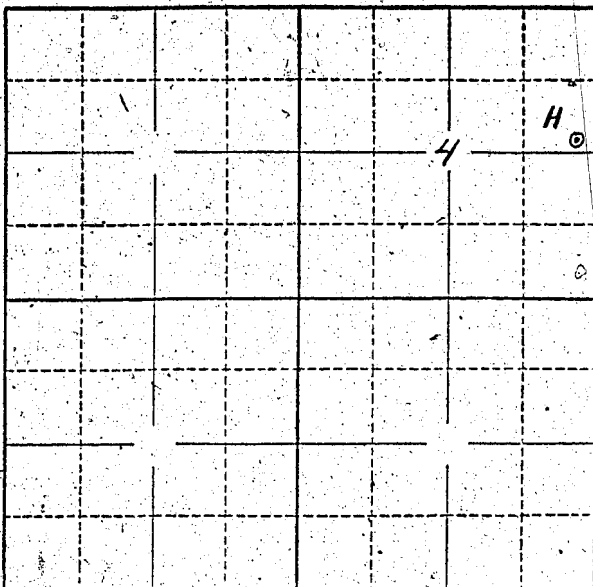

Locate well and acreage of irrigated land on plat.
Scale: 2" = 1 Mile

STATE OF OREGON


} ss.

I, MAXINE ARNOLD THOMAS being first duly sworn, do hereby certify that I have read the foregoing Registration Statement and that all of the items therein contained are true to the best of my knowledge and belief.

Maxine Arnold Thomas
(Signature of Registrant)

Subscribed and sworn to before me this 31st day of July, 1958

My commission expires Sept. 28 1961

E. W. [Signature]
(Notary Public)

(SEAL)

CERTIFICATE OF REGISTRATION

STATE OF OREGON

County of Marion

} ss.

This is to certify that the foregoing Registration Statement was received in the office of the State Engineer on the 1st day of August, 1958, at 2:00 o'clock A.M. and has been duly recorded in said office in Book No. 14 of Registration Statements on page GR- 3421

Witness my hand this 20th day of August, 1959

Clara A. Stanley
(State Engineer)

By [Signature]
(Deputy)

\$15.00

GR 3421