

# Registration Statement

## OF CLAIMANT OF RIGHT TO APPROPRIATE GROUND WATER

TO THE STATE ENGINEER OF OREGON:

I, Edmond CROWSON

of JUNCTION CITY County of BENTON

State of OREGON, do hereby make application for a certificate of registration as evidence of a right to appropriate ground water.

1. Source from which water is withdrawn is Pump Well #2

(Flowing well, pump well, infiltration trench, or tunnel)

2. Location is: 3 1/2 MILE EAST OF MONROE

(Approximate distance and direction from nearest city or town.)

and is more particularly described as follows:

(a) 1971 East and 632' South of NW Cor. Sec 31

(Give distance and bearing to corner of section or other legal subdivision)

being within NE 1/4 NW 1/4 of Sec. 31, Twp. 14S, Rge. 4W

(Smallest legal subdivision)

(N. or S.)

(E. or W.)

or (b) within limits of recorded platted property, town or city:

in Lot \_\_\_\_\_, Block \_\_\_\_\_ of \_\_\_\_\_

(Name of plat or addition)

County of \_\_\_\_\_

(If within city or town, give name)

3. Construction Work was begun on APRIL 1952, was completed on APRIL 1952

(Date)

(Date)

and the ground water claimed was first used for the purposes set out below on MAY 1952

(Date)

since which time the water has been used INTERMITTENTLY

(Continuously or intermittently)

from 1952 to 1958

(Date)

(Date)

4. Quantity of water claimed and used is 450 gallons per minute; 60 acre feet per year.

5. Purpose or Purposes for which water is used IRRIGATION

(Domestic, irrigation, municipal, manufacturing, industrial, etc.)

6. Description of Well: Depth 25 feet Type DRIVEN

(Dug or drilled)

diameter 4" inches. Elevation of ground at well site 260 feet, mean sea level.

(As near as known)

Depth to water table 12 feet.

7. Capacity of Well: 450 g.p.m. with 2-4 feet drawdown.

g.p.m. with \_\_\_\_\_ feet drawdown.

Date of test \_\_\_\_\_

If Flowing Well: Measured discharge \_\_\_\_\_ g.p.m. on \_\_\_\_\_

(Date)

Shut-in pressure at ground surface \_\_\_\_\_ lbs. per sq. in. on \_\_\_\_\_

(Date)


Water is controlled by \_\_\_\_\_

(Cap, valve, etc.)





Township (145) Range 4W, W.M.  
North

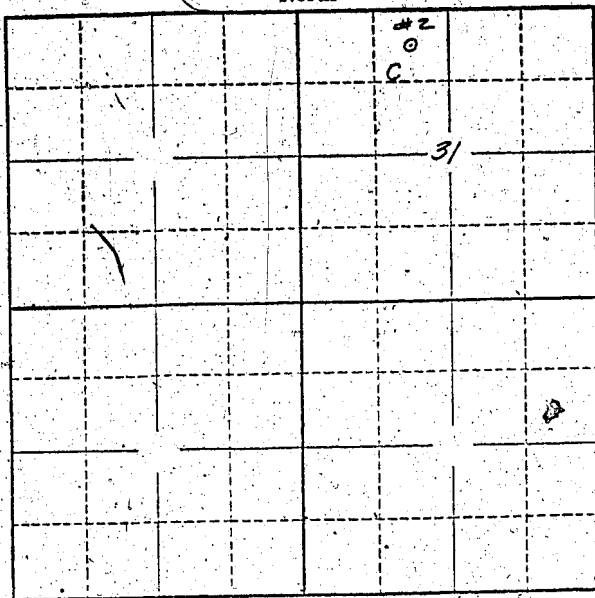

Locate well and acreage of irrigated land on plat.  
Scale: 2" = 1 Mile

STATE OF OREGON } ss.  
County of Lane

I, Edmond Crowson, being first duly sworn, do hereby certify that I have read the foregoing Registration Statement and that all of the items therein contained are true to the best of my knowledge and belief.

Edmond Crowson  
(Signature of Registrant)

Subscribed and sworn to before me this 31st day of July, 19 58

My commission expires Dec. 15, 1961

Virginia M. Norris  
(Notary Public)

(SEAL)

**CERTIFICATE OF REGISTRATION**

STATE OF OREGON } ss.  
County of Marion

This is to certify that the foregoing Registration Statement was received in the office of the State Engineer on the 1st day of August, 1958, at 7:00 o'clock A. M. and has been duly recorded in said office in Book No. 14 of Registration Statements on page GR-3424

Witness my hand this 20th day of August, 19 59

Laura A. Stanley  
(State Engineer)

#15.00

By \_\_\_\_\_ (Deputy)

GR 3424