

Registration Statement

OF CLAIMANT OF RIGHT TO APPROPRIATE GROUND WATER

(Under Chapter 708, Oregon Laws 1955.)

TO THE STATE ENGINEER OF OREGON:

I, S. P. HUGHES

of 599 LONE PINE DRIVE County of LANE

State of ORE. do hereby make application for a certificate of registration as evidence of a right to appropriate ground water.

1. Source from which water is withdrawn is PUMP WELL #1
(Flowing well, pump well, infiltration trench, or tunnel)

2. Location is: 6 MILES SO OF JUNCTION CITY, ORE.
(Approximate distance and direction from nearest city or town)

and is more particularly described as follows:

(a) 2175 S. 80° W. OF THE CENTER OF SEC. 23
(Give distance and bearing to corner of section or other legal subdivision)

being within NW 1/4 SW 1/4 of Sec. 23, Twp. 16 S, Rge. 4 W
(Smallest legal subdivision) (N. or S.) (E. or W.)

or (b) within limits of recorded platted property, town or city:

in Lot _____, Block _____ of _____
(Name of plat or addition)

County of _____
(If within city or town, give name)

3. Construction Work was begun on UNKNOWN; was completed on UNKNOWN
(Date) (Date)

and the ground water claimed was first used for the purposes set out below on JUNE 1947
(Date)

since which time the water has been used CONT
(Continuously or intermittently)

from JUNE 1947 to PRESNT
(Date) (Date)

4. Quantity of water claimed and used is 16.8 gallons per minute; 7.5 acre feet per year.

5. Purpose or Purposes for which water is used IRRIGATION

(Domestic, irrigation, municipal, manufacturing, industrial, etc.)

6. Description of Well: Depth 25 feet. Type DRIVEN
(Dug or drilled)

diameter 3 inches. Elevation of ground at well site 375 feet, mean sea level
(As near as known)

Depth to water table 10 feet.

7. Capacity of Well: _____ g.p.m. with _____ feet drawdown.

_____ g.p.m. with _____ feet drawdown.


Date of test _____

If Flowing Well: Measured discharge _____ g.p.m. on _____
(Date)

Shut-in pressure at ground surface _____ lbs. per sq. in. on _____
(Date)

Water is controlled by _____
(Cap, valve, etc.)

Township 16 S Range 4 W, W.M.
North

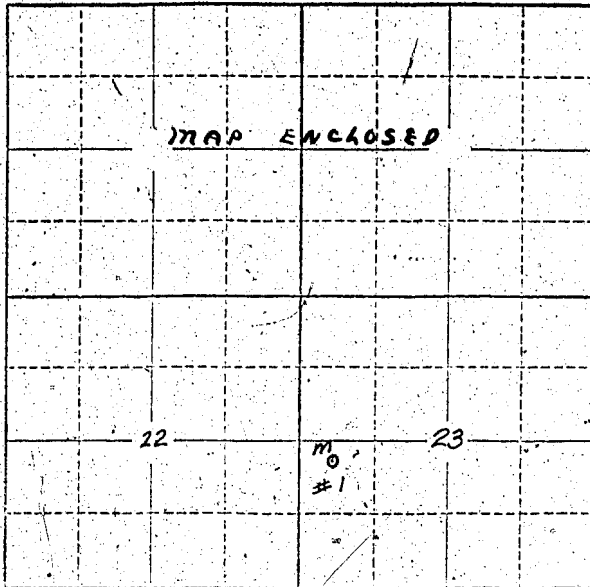

Locate well and acreage of irrigated land on plat.
Scale: 2" = 1 Mile

STATE OF OREGON

County of Lane } ss.

I, S. P. Hughes, being first duly sworn, do hereby certify that I have read the foregoing Registration Statement and that all of the items therein contained are true to the best of my knowledge and belief.

S. P. Hughes
(Signature of Registrant)

Subscribed and sworn to before me this 30 day of July, 1958

My commission expires 9-29-60
(Notary Public)

(SEAL)

CERTIFICATE OF REGISTRATION

STATE OF OREGON

County of Marion } ss.

This is to certify that the foregoing Registration Statement was received in the office of the State Engineer on the 13th day of August, 1958, at 2:00 o'clock P.M. and has been duly recorded in said office in Book No. 14 of Registration Statements on page GR-3425

~~xxxxxx~~
~~xxxxxx~~

Witness my hand this 20th day of August, 1959

Laura A. Stanley
(State Engineer)

\$15.00

By _____
(Deputy)