

Registration Statement

OF CLAIMANT OF RIGHT TO APPROPRIATE GROUND WATER

TO THE STATE ENGINEER OF OREGON:

I, Eliet Hitt

of 3458 Burrnell Rd Medford County of Jackson

State of Oregon, do hereby make application for a certificate of registration as evidence of a right to appropriate ground water.

1. Source from which water is withdrawn is Pump well
(Flowing well, pump well, infiltration trench, or tunnel)

2. Location is: 3/4 mile south east of Central Point
(Approximate distance and direction from nearest city or town)

and is more particularly described as follows: On lot 3 of Pitview Subdivison

(a) About 1790 feet west & 340 feet south from E 1/4 corner Section 11
(Give distance and bearing to corner of section or other legal subdivision)

being within NW 1/4 of SE 1/4 of Sec. 11, Twp. 37 S, Rge. 2 W.
(Smallest legal subdivision) (N. or S.) (E. or W.)

or (b) within limits of recorded platted property, town or city:

in Lot 3, Block _____ of Amended plat of Pitt View Acres
(Name of plat or addition)

County of Jackson
(If within city or town, give name)

3. Construction Work was begun on 1929; was completed on 1929
(Date) (Date)

and the ground water claimed was first used for the purposes set out below on _____
(Date)

since which time the water has been used Continually
(Continuously or intermittently)

from 1929 to present time
(Date) (Date)

4. Quantity of water claimed and used is 20 gallons per minute; _____ acre feet per year.

5. Purpose or Purposes for which water is used Irrigation

(Domestic, irrigation, municipal, manufacturing, industrial, etc.)

6. Description of Well: Depth 18 feet. Type dug
(Dug or drilled)

diameter 96 inches. Elevation of ground at well site 1290 feet, mean sea level.
(As near as known)

Depth to water table 6 feet.

7. Capacity of Well: 20 g.p.m. with 10 feet drawdown.

_____ g.p.m. with _____ feet drawdown.

Date of test None

If Flowing Well: Measured discharge _____ g.p.m. on _____
(Date)

Shut-in pressure at ground surface _____ lbs. per sq. in. on _____
(Date)

Water is controlled by _____
(Cap, valve, etc.)

8. Casing: (Give diameter, commercial specifications and depth below ground surface of each casing size.)

$9\frac{1}{2}$ inch diameter concrete from 0 to 9 feet
9 inch diameter brick from 9 to 17 feet
 inch diameter from to feet
 inch diameter from to 4 feet

Describe and show depth of shoe, plug, adapter, liner or other details:

9. Perforated Casings or Screens:

None from to
 (Number per foot and size of perforations, or describe screen)
 from to
 from to
 from to

10. Log of Well: (Describe each stratum or formation clearly, indicate if water bearing, and give thickness and depth as indicated.)

MATERIAL	Thickness (Feet)	Depth to Bottom (Feet)
<u>Not known</u>		

If log of well is not available, give name and address of driller. *Not Known*

11. Infiltration Trench: Covered or open

Dimensions: Length ft. Minimum depth ft. Maximum depth ft.

Bottom width ft. Discharge g.p.m. Date of test

12. Tunnel: Type of lining

Dimensions:
(Length, course, and cross sectional size)

Position of water bearing stratum with reference to portal of tunnel

Log of tunnel: (Preceding table for log of well may be used, if desired. Give footage from portal and character of materials, as pertinent.)

13. Pumping Equipment:

(a) Pump *1 1/4 Centrifugal Pump (Wasco)* Capacity g.p.m.
(Make, type and size)


(b) Motor *3/4 HP. electric motor*
(Type and horsepower)

14. Location of area irrigated or to be irrigated, or place of use if for purposes other than irrigation.

Township North or South	Range E. or W. of Willamette Meridian	Section	Forty-acre Tract	Number Acres To Be Irrigated	Date of Reclamation
<i>T.37S</i>	<i>R.2W.</i>	<i>11</i>	<i>NW 1/4 of SE 1/4</i>	<i>1.5 Ac</i>	<i>1929</i>

15. If the ground water supply is supplemental to an existing water supply, identification of any application for a permit, permit, certificate or adjudicated right to appropriate water made or held by the registrant.

Township 37 S Range 2 W, W.M.
North

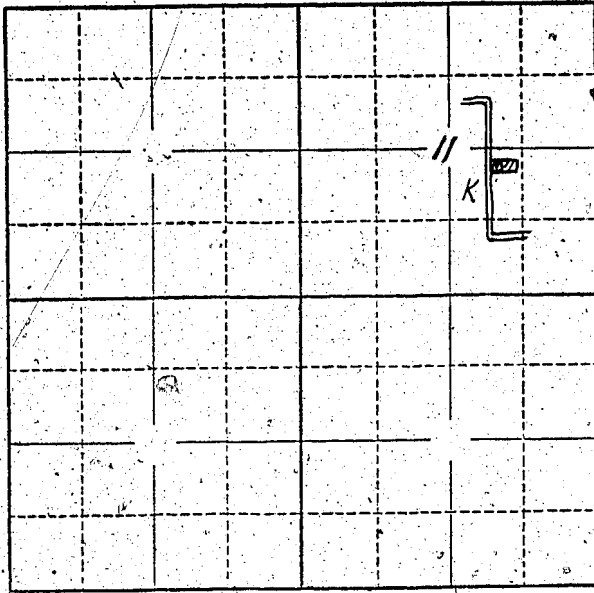

Locate well and acreage of irrigated land on plat.
Scale: 2" = 1 Mile

*n. n.w. 1/4 of
S. 1/4 E. 1/4 of*

STATE OF OREGON

County of JACKSON

} ss.

I, ELLET HITT, being first duly sworn, do hereby certify that I have read the foregoing Registration Statement and that all of the items therein contained are true to the best of my knowledge and belief.

Ellet Hitt

(Signature of Registrant)

Subscribed and sworn to before me this 31st day of July, 1958

My commission expires June 12, 1960

Norman T. [unclear]

(Notary Public)

(SEAL)

CERTIFICATE OF REGISTRATION

STATE OF OREGON

County of Marion

} ss.

This is to certify that the foregoing Registration Statement was received in the office of the State Engineer on the 1st day of August, 1958, at 2:00 o'clock A.M. and has been duly recorded in said office in Book No. 14 of Registration Statements on page 3431

Witness my hand this 20th day of August, 1959

\$15.00

Lewis A. Stanley

(State Engineer)

By

(Deputy)

GR 3431