

Registration Statement

OF CLAIMANT OF RIGHT TO APPROPRIATE GROUND WATER

TO THE STATE ENGINEER OF OREGON:

I, Ralph W. Watters

of Rt 2 Box 317 Troutdale

County of Multnomah

State of Oregon, do hereby make application for a certificate of registration as evidence of a right to appropriate ground water.

1. Source from which water is withdrawn is pump well #2
(Flowing well, pump well, infiltration trench, or tunnel)

2. Location is: 1/2 mi west of Fairview
(Approximate distance and direction from nearest city or town)

and is more particularly described as follows:

(a) S 65° 30' W, NE cor Sec 28, 2880'
(Give distance and bearing to corner of section or other legal subdivision)

being within NW 1/4 NE 1/4 of Sec. 28, Twp. 1 N, Rge. 3 E
(Smallest legal subdivision) (N. or S.) (E. or W.)

or (b) within limits of recorded platted property, town or city:

in Lot _____, Block _____ of _____
(Name of plat or addition)

County of _____
(If within city or town, give name)

3. Construction Work was begun on June 1942; was completed on June 1942
(Date) (Date)

and the ground water claimed was first used for the purposes set out below on July 1942
(Date)

since which time the water has been used intermittently
(Continuously or intermittently)

from April 1942 to October 1958
(Date) (Date)

4. Quantity of water claimed and used is 50 gallons per minute; 63 acre feet per year.

5. Purpose or Purposes for which water is used: irrigation & domestic

supplying water to the several homes located on place
Domestic (irrigation, municipal, manufacturing, industrial, etc.) stock (exempt)

6. Description of Well: Depth 49 feet. Type drilled
(Dug or drilled)

diameter 6 inches. Elevation of ground at well site 60 feet, mean sea level.
(As near as known)

Depth to water table 32 feet.

7. Capacity of Well: 250 g.p.m. with 10 feet drawdown.

_____ g.p.m. with _____ feet drawdown.


Date of test July 1942

If Flowing Well: Measured discharge _____ g.p.m. on _____
(Date)

Shut-in pressure at ground surface _____ lbs. per sq. in. on _____
(Date)

Water is controlled by _____
(Cap, valve, etc.)

Township 1N Range 3E W.M.
North

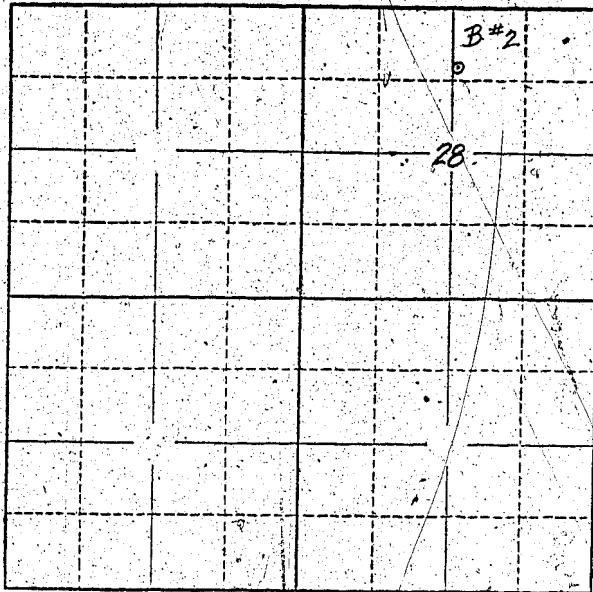

Locate well and acreage of irrigated land on plat.
Scale: 2" = 1 Mile

STATE OF OREGON

County of Multnomah

ss.

I, Ralph W. Watters, being first duly sworn, do hereby certify that I have read the foregoing Registration Statement and that all of the items therein contained are true to the best of my knowledge and belief.

Ralph W. Watters
(Signature of Registrant)

Subscribed and sworn to before me this 31st day of July, 1958

My commission expires 12-9-60

Walter C. ...
(Notary Public)

(SEAL)

CERTIFICATE OF REGISTRATION

STATE OF OREGON

County of Marion

ss.

This is to certify that the foregoing Registration Statement was received in the office of the State Engineer on the 1 day of August, 1958, at 8.00 o'clock A.M. and has been duly recorded in said office in Book No. 16 of Registration Statements on page GR 3813

Witness my hand this 4th day of December, 1959

Lewis A. Stanley
(State Engineer)

By

(Deputy)