

Registration Statement

REGISTRATION GR-3774
CERTIFICATE NO. GR-3432

OF CLAIMANT OF RIGHT TO APPROPRIATE GROUND WATER

(Under Chapter 708, Oregon Laws 1955.)

TO THE STATE ENGINEER OF OREGON:

I, ^{Mrs.} JOHN R. MEEK

of Box 395, Canby County of CLATSOP

State of OREGON do hereby make application for a certificate of registration as evidence of a right to appropriate ground water.

1. Source from which water is withdrawn is Pumped well
(Flowing well, pump well, infiltration trench, or tunnel)

2. Location is: NORTH EDGE OF THE CITY OF CANBY
(Approximate distance and direction from nearest city or town)

and is more particularly described as follows:

(a) N 9°30'E, 2240 FEET FROM SW CORNER OF SECTION 33
(Give distance and bearing to corner of section or other legal subdivision)

being within NW 1/4 SW 1/4 of Sec. 33, Twp. 35, Rge. 1E
(Smallest legal subdivision) (N. or S.) (E. or W.)

or (b) within limits of recorded platted property, town or city:

in Lot _____, Block _____ of _____
(Name of plat or addition)

Canby County of Clatsop
(If within city or town, give name)

3. Construction Work was begun on 2-8-49; was completed on 3-2-49
(Date) (Date)

and the ground water claimed was first used for the purposes set out below on June 49
(Date)

since which time the water has been used Continuously
(Continuously or intermittently)

from June 49 to 9-20-56
(Date) (Date)

4. Quantity of water claimed and used is 250 gallons per minute; _____ acre feet per year.

5. Purpose or Purposes for which water is used IRRIGATION

(Domestic, irrigation, municipal, manufacturing, industrial, etc.)

6. Description of Well: Depth 200 feet. Type Drilled
(Dug or drilled)

diameter 6 inches. Elevation of ground at well site 125 feet, mean sea level.
(As near as known)

Depth to water table 53 feet.

7. Capacity of Well: 200 g.p.m. with 3.5 feet drawdown.

250 g.p.m. with 53 feet drawdown.

Date of test 2/11/49

If Flowing Well: Measured discharge _____ g.p.m. on _____
(Date)

Shut-in pressure at ground surface _____ lbs. per sq. in. on _____
(Date)

Water is controlled by _____
(Cap, valve, etc.)

8. Casing: (Give diameter, commercial specifications and depth below ground surface of each casing size.)

..... inch diameter from 0 to 200 feet
 inch diameter from to feet
 inch diameter from to feet
 inch diameter from to feet

Describe and show depth of shoe, plug, adapter, liner or other details:


9. Perforated Casings or Screens:

5 Perforations Per Ft. Per Row 3 Rows from 90 to 100
(Number per foot and size of perforations, or describe screen)
 " " " " 4 Rows from 190 to 200
 from to

10. Log of Well: (Describe each stratum or formation clearly, indicate if water bearing, and give thickness and depth as indicated.)

MATERIAL	Thickness (Feet)	Depth to Bottom (Feet)
Sand & Gravel	0	22
Cement Gravel & Boulders	22	43
Blue clay	113	61
Cement Gravel (Blue clay binder)	61	78
Fine sand	78	89
Red gravel & Blue clay (some water)	89	98
Blue clay	98	113
Dark Blue silt	143	170
Light Blue clay	170	184
Very Dark Clay	184	198
sand & small gravel	198	200

Township 35 Range 1E, W.M.
North

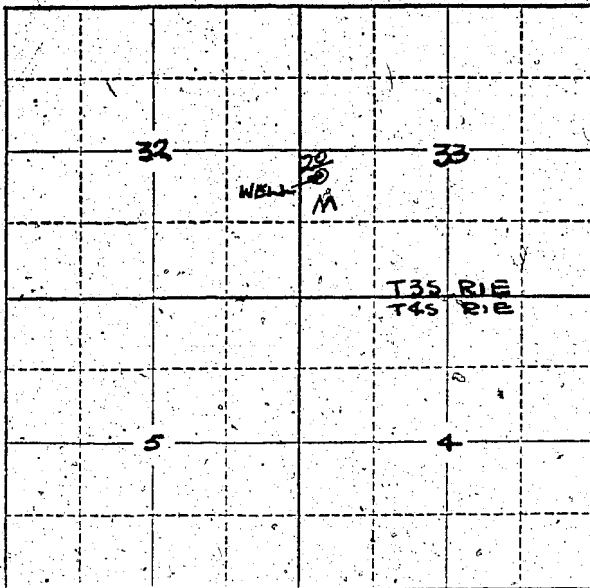

Locate well and acreage of irrigated land on plat.

Scale: 2" = 1 Mile.

STATE OF OREGON

County of Clackamas

ss.

I, Mrs. John R. Meek, being first duly sworn, do hereby certify that I have read the foregoing Registration Statement and that all of the items therein contained are true to the best of my knowledge and belief.

Mrs. John R. Meek
(Signature of Registrant)

Subscribed and sworn to before me this 31 day of July, 1958.

My commission expires July 22, 1961

(Notary Public)

(SEAL)

CERTIFICATE OF REGISTRATION

STATE OF OREGON

County of Marion

ss.

This is to certify that the foregoing Registration Statement was received in the office of the State Engineer on the 1 day of August, 1958, at 8:00 o'clock A. M. and has been duly recorded in said office in Book No. 14 of Registration Statements on page GR 3432

~~Construction shall be completed by _____ 19____ and the water completely applied to the beneficial use by _____ 19____.~~

Witness my hand this 20th day of August, 1959.

Lewis A. Stanley
(State Engineer)

By _____
(Deputy)

\$15.00

GR-3432