

Registration Statement

OF CLAIMANT OF RIGHT TO APPROPRIATE GROUND WATER

(Under Chapter 708, Oregon Laws 1955.)

TO THE STATE ENGINEER OF OREGON:

I, Clarence Lyone
 of Silverton County of Marion
 State of Oregon, do hereby make application for a certificate of registration as evidence
 of a right to appropriate ground water.

1. Source from which water is withdrawn is Pump Well
(Flowing well, deep well, infiltration trench, or tunnel)

2. Location is: One mile East of Silverton
(Approximate distance and direction from nearest city or town)

and is more particularly described as follows:

(a) 8 1/2 chains west and 1/2 chain North from NW corner of Section 36
(Give distance and bearing to corner of section or other legal subdivision)

being within SE 1/4 of SE 1/4 of Sec. 36, Twp. 6S, Rge. 1W
(Smallest legal subdivision) (N. or S.) (E. or W.)

or (b) within limits of recorded platted property, town or city: _____

in Lot _____, Block _____ of _____
(Name of plat or addition)

_____ County of _____
(If within city or town, give name)

3. Construction Work was begun on July 1936; was completed on 1936
(Date) (Date)

and the ground water claimed was first used for the purposes set out below on 1936
(Date)

since which time the water has been used Continuously
(Continuously or intermittently)

from 1936 to 1957
(Date) (Date)

4. Quantity of water claimed and used is 60 gallons per minute; _____ acre
 feet per year.

5. Purpose or Purposes for which water is used Irrigation
and Domestic
(Domestic, irrigation, municipal, manufacturing, industrial)

6. Description of Well: Depth 180 feet. Type Drilled
(Dug or drilled)

diameter 8 1/2 inches. Elevation of ground at well site 320 feet, mean sea level.
(As near as known)

Depth to water table 59 feet.

7. Capacity of Well: 60 g.p.m. with _____ feet drawdown. As possible to install
airline due to crooked
well

_____ g.p.m. with _____ feet drawdown.

Date of test 2-25-57

If Flowing Well: Measured discharge _____ g.p.m. on _____
(Date)

Shut-in pressure at ground surface _____ lbs. per sq. in. on _____
(Date)

Water is controlled by _____
(Cap, valve, etc.)

8. Casing: (Give diameter, commercial specifications and depth below ground surface of each casing size.)

6 inch diameter *steel casing* from 0 to 30 feet
 6 inch diameter *rock wall (open hole)* from 30 to 140 feet
 inch diameter from to feet
 inch diameter from to feet

Describe and show depth of shoe, plug, adapter, liner or other details:

9. Perforated Casings or Screens:

unknown from to
 (Number per foot and size of perforations, or describe screen)
 from to
 from to
 from to

10. Log of Well: (Describe each stratum or formation clearly, indicate if water bearing, and give thickness and depth as indicated.)

MATERIAL	Thickness (Feet)	Depth to Bottom (Feet)
<i>unknown</i>		

If log of well is not available, give name and address of driller: Johnson

X 11. Infiltration Trench: Covered or open

Dimensions: Length _____ ft. Minimum depth _____ ft. Maximum depth _____ ft.
 Bottom width _____ ft. Discharge _____ g.p.m. Date of test _____

X 12. Tunnel: Type of lining

Dimensions: _____
(Length, course, and cross sectional size)
 Position of water bearing stratum with reference to portal of tunnel _____

Log of tunnel: (Preceding table for log of well may be used, if desired. Give footage from portal and character of materials, as pertinent.)

13. Pumping Equipment:


(a) Pump Pomona Turbine Capacity 100 g.p.m.
(Make, type and size)
 (b) Motor 5 H.P.
(Type and horsepower)

14. Location of area irrigated or to be irrigated, or place of use if for purposes other than irrigation.

Township North or South	Range E or W. of Willamette Meridian	Section	Forty-acre Tract	Number Acres To Be Irrigated	Date of Reclamation
T6S	R1W	26	SE 1/4 of SE 1/4	3.5	1936
"	"	35	NE 1/4 of NE 1/4	13.0	1936
"	"	36	NW 1/4 of NW 1/4	4.5	1936
				21.0 AC.	

15. If the ground water supply is supplemental to an existing water supply, identification of any application for a permit, permit, certificate or adjudicated right to appropriate water made or held by the registrant.

Township 6S Range 1W W.M.
North

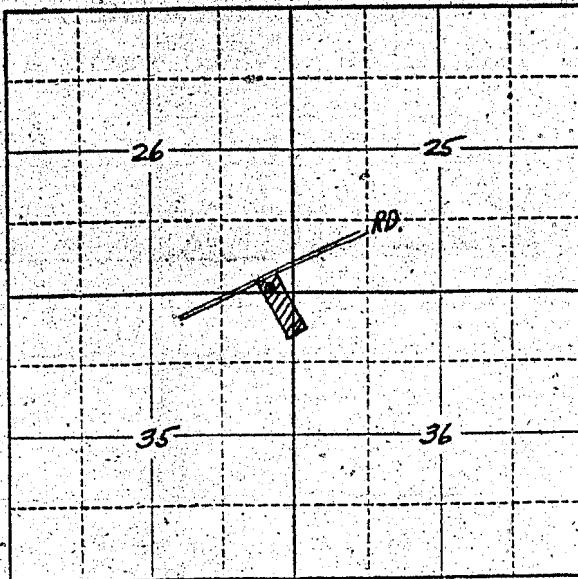

Locate well and acreage of irrigated land on plat.

Scale: 2" = 1 Mile

STATE OF OREGON

County of Marion

} ss.

I, Clarence Lusne, being first duly sworn, do hereby certify that I have read the foregoing Registration Statement and that all of the items therein contained are true to the best of my knowledge and belief.

Clarence Lusne
(Signature of Registrant)

Subscribed and sworn to before me this 26th day of February, 1957.

My commission expires Sept 8, 1960

Chas. Z. Wheeler
(Notary Public)

(SEAL)

CERTIFICATE OF REGISTRATION

STATE OF OREGON

County of Marion

} ss.

This is to certify that the foregoing Registration Statement was received in the office of the State Engineer on the 26th day of February, 1957 at 2:00 o'clock P. M. and has been duly recorded in said office in Book No. 3 of Registration Statements on page GR-364 C.

~~Construction shall be completed by~~ ~~XXXXXXXXXXXXXX~~ ~~and the water completely split out~~ ~~by~~ ~~XXXXXXXXXXXXXX~~

Witness my hand this 30th day of April, 1957.

Lawrence A. Stanley
(State Engineer)

By _____ (Deputy)

1500

GR 364 C