

Registration Statement

OF CLAIMANT OF RIGHT TO APPROPRIATE GROUND WATER

TO THE STATE ENGINEER OF OREGON:

I, Claude V. Wood

of Rt. 4, Box 355, Corvallis County of Linn

(Mailing address)

State of Oregon, do hereby make application for a certificate of registration as evidence of a right to appropriate ground water.

1. Source from which water is withdrawn is pump well

(Flowing well, pump well, infiltration trench, or tunnel)

2. Location is: 3 miles SE of Corvallis, Oregon

(Approximate distance and direction from nearest city or town)

and is more particularly described as follows:

(a) 1911 feet S. and 1089 feet East of NW corner S. 8, T. 12 S, R. 1 W.

(Give distance and bearing to corner of section or other legal subdivision)

being within SW 1/4 of NW 1/4 of Sec. 8 Twp. 12 S, Rge. 1 W

(Smallest legal subdivision)

(N. or S.)

(E. or W.)

or (b) within limits of recorded platted property, town or city:

in Lot _____, Block _____ of _____

(Name of plat or addition)

County of Linn

(If within city or town, give name)

3. Construction Work was begun on 1953, was completed on 1953

(Date)

(Date)

and the ground water claimed was first used for the purposes set out below on 1953

(Date)

since which time the water has been used continuously

(Continuously or intermittently)

from 1953 to present time

(Date)

(Date)

4. Quantity of water claimed and used is 75 gallons per minute; 18.75 acre feet per year.

5. Purpose or Purposes for which water is used Irrigation

(Domestic, irrigation, municipal, manufacturing, industrial, etc.)

6. Description of Well: Depth 31 feet. Type Drilled

(Dug or drilled)

diameter 6 inches. Elevation of ground at well site 210 feet, mean sea level.

(As near as known)

Depth to water table _____ feet.

7. Capacity of Well: _____ g.p.m. with _____ feet drawdown.

_____ g.p.m. with _____ feet drawdown.

Date of test not tested

If Flowing Well: Measured discharge _____ g.p.m. on _____

(Date)

Shut-in pressure at ground surface _____ lbs. per sq. in. on _____

(Date)

Water is controlled by _____

(Cap, valve, etc.)

8. Casing: (Give diameter, commercial specifications and depth below ground surface of each casing size.)

6 inch diameter steel casing from 0 to 31 feet
 inch diameter from to feet
 inch diameter from to feet
 inch diameter from to feet

Describe and show depth of shoe, plug, adapter, liner or other details:


9 Perforated Casings or Screens:

Unknown from to
 (Number per foot and size of perforations, or describe screen)
 from to
 from to
 from to

10. Log of Well: (Describe each stratum or formation clearly, indicate if water bearing, and give thickness and depth as indicated.)

MATERIAL	Thickness (Feet)	Depth to Bottom (Feet)
Not available		

Township 12 S Range 4 W, W.M.
North

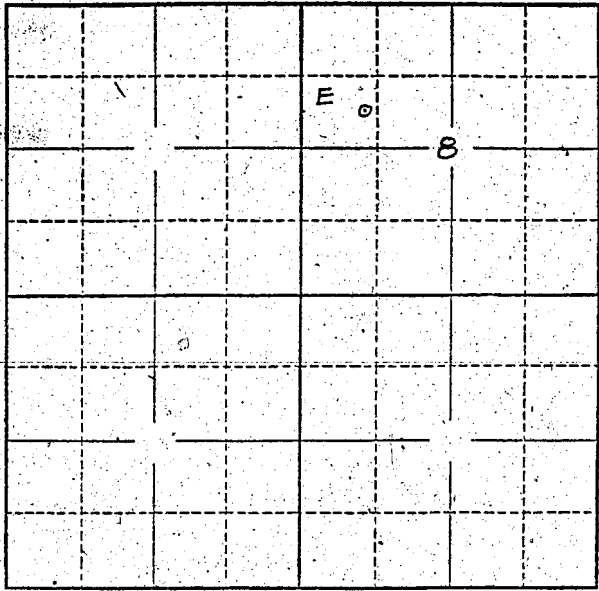

Locate well and acreage of irrigated land on plat.
Scale: 2" = 1 Mile

STATE OF OREGON }
County of CLATSOP LINN } ss.

I, Clauda V. Wood, being first duly sworn, do hereby certify that I have read the foregoing Registration Statement and that all of the items therein contained are true to the best of my knowledge and belief.

Clauda V. Wood
(Signature of Registrant)

Subscribed and sworn to before me this 24th day of July, 1958, 19

My commission expires Aug. 12, 1959
Pauline R. Burke
(Notary Public)
Notary Public for Oregon

(SEAL)

CERTIFICATE OF REGISTRATION

STATE OF OREGON }
County of Marion } ss.

This is to certify that the foregoing Registration Statement was received in the office of the State Engineer on the 1 day of August, 1958, at 8:00 o'clock A. M. and has been duly recorded in said office in Book No. 14 of Registration Statements on page GR-3439

Witness my hand this 20th day of August, 1959
Louis A. Stanley
(State Engineer)

By _____ (Deputy)

\$15.00

GR 3439