

# Registration Statement

## OF CLAIMANT OF RIGHT TO APPROPRIATE GROUND WATER

TO THE STATE ENGINEER OF OREGON:

DBA ASO REX NUT CO

I, W.M. & MARGARET S. HAYS

of PT. 2 Box 312, NEWBERG ONE county of YAM HILL

State of OREGON, do hereby make application for a certificate of registration as evidence of a right to appropriate ground water.

1. Source from which water is withdrawn is PUMP WELL  
(Flowing well, pump well, infiltration trench, or tunnel)

2. Location is: 2 3/4 N.E. OF NEWBERG, CHEHALEM MT. AT REX  
(Approximate distance and direction from nearest city or town)

and is more particularly described as follows:

(a) 752 FT. WEST - 25 FT. SOUTH OF SE CORNER <sup>sec. 10</sup> TWP 35 - RANGE 2  
(Give distance and bearing to corner of section or other legal subdivision)

being within NE 1/4 OF NE 1/4 of Sec. 15, Twp. 35, Rge. 2W  
(Smallest legal subdivision) (N. or S.) (E. or W.)

or (b) within limits of recorded platted property, town or city: \_\_\_\_\_

in Lot \_\_\_\_\_, Block \_\_\_\_\_ of \_\_\_\_\_  
(Name of plat or addition)

County of \_\_\_\_\_  
(If within city or town, give name)

3. Construction Work was begun on JUNE 1920; was completed on JULY 1920  
(Date) (Date)

and the ground water claimed was first used for the purposes set out below on JULY 1920  
(Date)

since which time the water has been used CONTINUOUSLY  
(Continuously or intermittently)

from JULY 1920 to JULY 28 1958  
(Date) (Date)

4. Quantity of water claimed and used is 16 2/3 gallons per minute; \_\_\_\_\_ acre feet per year.

5. Purpose or Purposes for which water is used ~~domestic~~ NUT DRYING AND PROCESSING PLANT & GARDEN IRRIGATION (1000)  
(Domestic, irrigation, municipal, manufacturing, industrial, etc.)

6. Description of Well: Depth 208 feet. Type DRILLED  
(Dug or drilled)

diameter 6 inches. Elevation of ground at well site 400 FT. feet, mean sea level.  
(As near as known)

Depth to water table 32 feet.

7. Capacity of Well: 16 2/3 g.p.m. with 6 feet drawdown.

\_\_\_\_\_ g.p.m. with \_\_\_\_\_ feet drawdown.

Date of test 3/9/58

If Flowing Well: Measured discharge \_\_\_\_\_ g.p.m. on \_\_\_\_\_  
(Date)

Shut-in pressure at ground surface \_\_\_\_\_ lbs. per sq. in. on \_\_\_\_\_  
(Date)


Water is controlled by \_\_\_\_\_  
(Cap. valve, etc.)

BAILED AT 1000 GAL PER HOUR FOR 7 HRS NO APPRECIABLE DRAW DOWN





Township 3 S Range 2 W, W.M. 4  
North

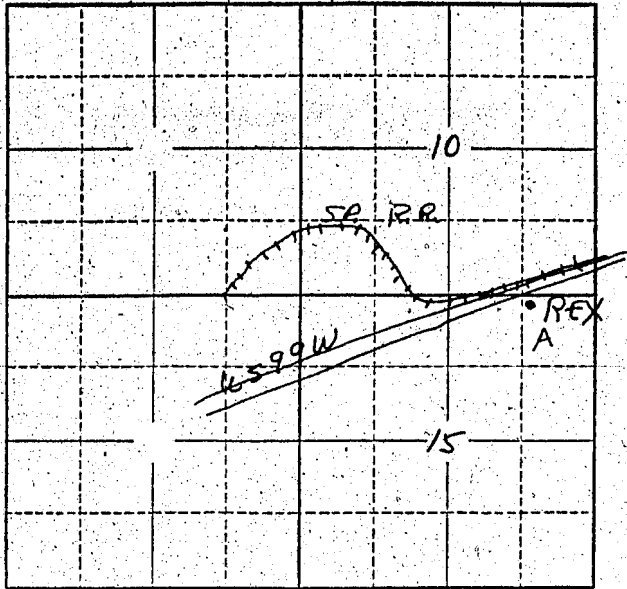

Locate well and acreage of irrigated land on plat.  
Scale: 2" = 1 Mile

STATE OF OREGON

County of YAMHILL } ss.

I, W. M. HAYS, being first duly sworn, do hereby certify that I have read the foregoing Registration Statement and that all of the items therein contained are true to the best of my knowledge and belief.

W M Hays  
(Signature of Registrant)

Subscribed and sworn to before me this 1st day of August, 1958

My commission expires 12th June 1961 Wm. S. Bartholomew  
(Notary Public)

(SEAL)

**CERTIFICATE OF REGISTRATION**

STATE OF OREGON } ss.  
County of Marion

This is to certify that the foregoing Registration Statement was received in the office of the State Engineer on the 1st day of August, 1958, at 1<sup>00</sup> o'clock P. M., and has been duly recorded in said office in Book No. 14 of Registration Statements on page GR-3445

Witness my hand this 15<sup>th</sup> day of September, 1959

Lewis A. Stanley  
(State Engineer)

By \_\_\_\_\_ (Deputy)

# 25.00