Registration No. GR-3785

Certificate No. GR 3446

Registration Statement

OF CLAIMANT OF RIGHT TO APPROPRIATE GROUND WATER

TO THE STATE ENGINEER OF OREGON:

I, GEORGE HANNAFORD,

of Rt 2, Box 225, LEBANON (Mailing address) County of LINN

State of OREGON, do hereby make application for a certificate of registration as evidence of a right to appropriate ground water.

1. **Source** from which water is withdrawn is PUMP WELL (Flowing well, pump well, infiltration trench, or tunnel)

2. **Location** is: 5 MILES N. OF LEBANON, OREGON (Approximate distance and direction from nearest city or town);

and is more particularly described as follows:

(a) 1386' N. AND 264' W. OF SE CORNER S. 21, T. 11S., R. 2W (Give distance and bearing to corner of section or other legal subdivision)

being within NE ¼ OF SE ¼ (Smallest legal subdivision) of Sec. 21, Twp. 11 S. (N. or S.), Rge. 2W (E. or W.)

or (b) within limits of recorded platted property, town or city:

in Lot ....., Block ....., of ..... (Name of plat or addition)

..... (If within city or town, give name) County of LINN

3. **Construction Work** was begun on MAY 1955 (Date); was completed on MAY 1955 (Date)

and the ground water claimed was first used for the purposes set out below on MAY 1955 (Date),

since which time the water has been used CONTINUOUSLY (Continuously or intermittently)

from MAY 1955 (Date) to PRESENT TIME (Date)

4. **Quantity** of water claimed and used is 190 gallons per minute; 168.0 acre feet per year.

5. **Purpose or Purposes** for which water is used IRRIGATION

..... (Domestic, irrigation, municipal, manufacturing, industrial, etc.)

6. **Description of Well:** Depth 14 feet. Type DUG (Dug or drilled)

diameter 10' x 35' ~~inches~~. Elevation of ground at well site 300 (As near as known) feet, mean sea level.

Depth to water table 6 feet.

7. **Capacity of Well:** ..... g.p.m. with ..... feet drawdown.

..... g.p.m. with ..... feet drawdown.

Date of test NOT TESTED

If Flowing Well: Measured discharge ..... g.p.m. on ..... (Date)

Shut-in pressure at ground surface ..... lbs. per sq. in. on ..... (Date)

Water is controlled by ..... (Cap, valve, etc.)

8. **Casing:** (Give diameter, commercial specifications and depth below ground surface of each casing size.)

..... inch diameter ....NONE.... from ..... to ..... feet

..... inch diameter ..... from ..... to ..... feet

..... inch diameter ..... from ..... to ..... feet

..... inch diameter ..... from ..... to ..... feet

Describe and show depth of shoe, plug, adapter, liner or other details: .....

.....

.....

9. **Perforated Casings or Screens:**

....NONE.... from ..... to .....
(Number per foot and size of perforations, or describe screen)

..... from ..... to .....

..... from ..... to .....

..... from ..... to .....

10. **Log of Well:** (Describe each stratum or formation clearly, indicate if water bearing, and give thickness and depth as indicated.)

MATERIAL	Thickness (Feet)	Depth to Bottom (Feet)
NOT AVAILABLE		

GR 3446

If log of well is not available, give name and address of driller. D.A.M. GARSON, ALBANY, ORE

11. **Infiltration Trench:** Covered or open .....

Dimensions: Length 35 ft. Minimum depth ..... ft. Maximum depth 14 ft.

Bottom width 10 ft. Discharge ..... g.p.m. Date of test .....

12. **Tunnel:** Type of lining .....

Dimensions: .....
(Length, course, and cross sectional size)

Position of water bearing stratum with reference to portal of tunnel .....

Log of tunnel: (Preceding table for log of well may be used, if desired. Give footage from portal and character of materials, as pertinent.)

13. **Pumping Equipment:**

(a) Pump BERKELEY 4" CENT. (Make, type and size) Capacity UNKNOWN 200 g.p.m.

(b) Motor 15 H.P. ELECTRIC (Type and horsepower)

14. Location of area irrigated or to be irrigated, or place of use if for purposes other than irrigation.

Township North or South	Range E. or W. of Willamette Meridian	Section	Forty-acre Tract	Number Acres To Be Irrigated	Date of Reclamation
11S	2W	21	NW¼ OF SE¼	1.0	MAY 1955
11S	2W	21	NE¼ OF SE¼	8.0	" "
11S	2W	21	SW¼ OF SE¼	0.5	" "
11S	2W	21	SE¼ OF SE¼	30.0	" "
11S	2W	22	NW¼ OF SW¼	0.5	" "
11S	2W	22	SW¼ OF SW¼	16.0	" "
				56.0	

15. If the ground water supply is supplemental to an existing water supply, identification of any application for a permit, permit, certificate or adjudicated right to appropriate water made or held by the registrant.

.....

.....

GR 3446

Township 11 S. Range 2 W., W.M.

North

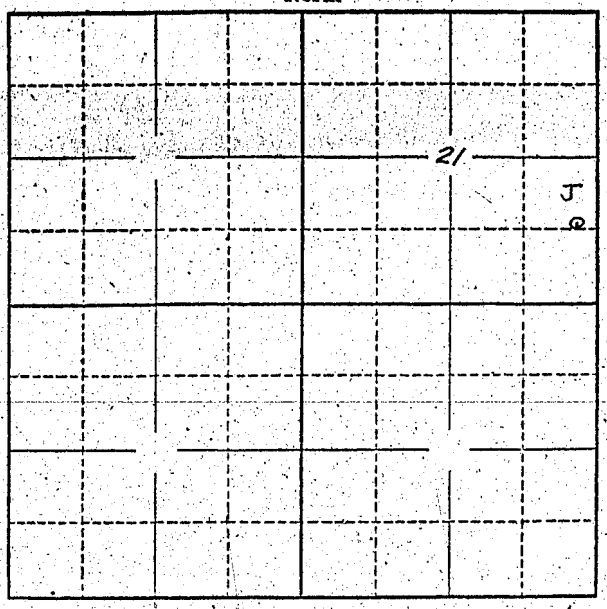

Locate well and acreage of irrigated land on plat.

Scale: 2" — 1 Mile

STATE OF OREGON
County of Linn } ss.

I, George Hannaford, being first duly sworn, do hereby certify that I have read the foregoing Registration Statement and that all of the items therein contained are true to the best of my knowledge and belief.

George Hannaford
(Signature of Registrant)

Subscribed and sworn to before me this 30th day of July, 1958.

My commission expires MY COMMISSION EXPIRES DEC. 4, 1958 George Andrus
(Notary Public)

(SEAL)

CERTIFICATE OF REGISTRATION

STATE OF OREGON
County of Marion } ss.

This is to certify that the foregoing Registration Statement was received in the office of the State Engineer on the 1 day of August, 1958, at 8.00 o'clock A. M. and has been duly recorded in said office in Book No. 14 of Registration Statements on page GR-3446

Witness my hand this 15th day of September, 1959

Lewis A. Stanley
(State Engineer)

By
(Deputy)

$18.90

GR 3446