RECEIVED
FEB 19 1957
STATE ENGINEER
SALEM, OREGON

RECEIVED
FEB 26 1957
STATE ENGINEER
SALEM, OREGON

REGISTRATION NO. GR-379
CERTIFICATE NO. GR 365

Registration Statement

OF CLAIMANT OF RIGHT TO APPROPRIATE GROUND WATER

(Under Chapter 708, Oregon Laws 1955.)

TO THE STATE ENGINEER OF OREGON:

I, Julius Wedeking,

of Route I, Box 878, Beaverton County of Washington

State of Oregon, do hereby make application for a certificate of registration as evidence of a right to appropriate ground water.

1. **Source from which water is withdrawn is** Pump Well
(Flowing well, pump well, infiltration trench, or tunnel)

2. **Location is:** 9 Miles S. W. Beaverton, Oregon;
(Approximate distance and direction from nearest city or town)

and is more particularly described as follows:
(Measured from photo)

(a) 410 ft. E and 150 ft. S of the NE corner of Thomas Humphrey DLC
(Give distance and bearing to corner of section or other legal subdivision)

being within NE 1/4 NW 1/4 (Smallest legal subdivision) of Sec. 12, Twp. 2S (N. or S.), Rge. 2W W M (E. or W.)

or (b) within limits of recorded platted property, town or city:

in Lot ....., Block ..... of ..... (Name of plat or addition)

..... (If within city or town, give name) County of .....

3. **Construction Work** was begun on April 1955 (Date); was completed on June 16 1955 (Date)

and the ground water claimed was first used for the purposes set out below on June 16, 1955 (Date),

since which time the water has been used continuously for house, and (Continuously or intermittently)

from May (Date) to October (Date) for irrigation.

4. **Quantity** of water claimed and used is 80 gallons per minute; 5 acre feet per year.

5. **Purpose or Purposes** for which water is used ~~Domestic and~~ Irrigation.
(Domestic, irrigation, municipal, manufacturing, industrial, etc.)

6. **Description of Well:** Depth 515 feet. Type Drilled (Dug or drilled)

diameter 8 inches. Elevation of ground at well site 175 (As near as known) feet, mean sea level.

Depth to water table 25 feet.

7. **Capacity of Well:** ..... g.p.m. with ..... feet drawdown.

80 g.p.m. with 135 feet drawdown.

Date of test June 16, 1955

If Flowing Well: Measured discharge ..... g.p.m. on ..... (Date)

Shut-in pressure at ground surface ..... lbs. per sq. in. on ..... (Date)

Water is controlled by ..... (Cap, valve, etc.)

8. **Casing:** (Give diameter, commercial specifications and depth below ground surface of each casing size.)

8 inch diameter Steel wall casing from 0 to 124 feet

8 inch diameter Rock from 124 to 315 feet

inch diameter from to feet

inch diameter from to feet

Describe and show depth of shoe, plug, adapter, liner or other details: None

9. **Perforated Casings or Screens:**

None from to
(Number per foot and size of perforations, or describe screen)

from to

from to

from to

10. **Log of Well:** (Describe each stratum or formation clearly, indicate if water bearing, and give thickness and depth as indicated.)

MATERIAL	Thickness (Feet)	Depth to Bottom (Feet)
Dirt	124	124
Rock	191	315

GR 365 A

If log of well is not available, give name and address of driller. A. J. Gaunt - Aloha, Oregon

11. **Infiltration Trench:** Covered or open None

Dimensions: Length ..... ft. Minimum depth ..... ft. Maximum depth ..... ft.

Bottom width ..... ft. Discharge ..... g.p.m. Date of test .....

12. **Tunnel:** Type of lining .....

Dimensions: .....
(Length, course, and cross sectional size)

Position of water bearing stratum with reference to portal of tunnel .....

Log of tunnel: (Preceding table for log of well may be used, if desired. Give footage from portal and character of materials, as pertinent.)

13. **Pumping Equipment:**

(a) Pump Jacuzzi Submersible (Make, type and size) Capacity 80 g.p.m.

(b) Motor 3 phase electric 7.5 H.P. (Type and horsepower)

14. Location of area irrigated or to be irrigated, or place of use if for purposes other than irrigation.

Township North or South	Range E. or W. of Willamette Meridian	Section	Forty-acre Tract	Number Acres To Be Irrigated	Date of Reclamation
2S	2W	12	NE 1/4 NW 1/4	15	June 1955

15. If the ground water supply is supplemental to an existing water supply, identification of any application for a permit, permit, certificate or adjudicated right to appropriate water made or held by the registrant.

.....

.....

Township 2S Range 2W, W.M.

North

Thomas Humphrey
D.L.C.

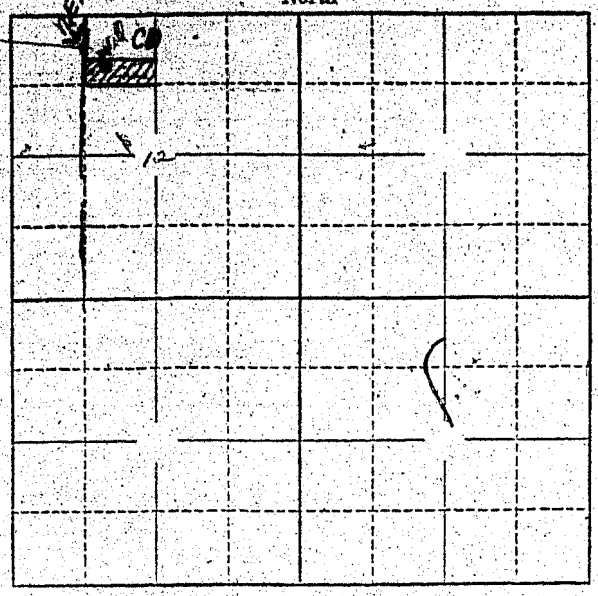

Locate well and acreage of irrigated land on plat.

Scale: 2" = 1 Mile

STATE OF OREGON
County of Washington } ss.

I, Julius Wedeking, being first duly sworn, do hereby certify that I have read the foregoing Registration Statement and that all of the items therein contained are true to the best of my knowledge and belief.

Julius Wedeking
(Signature of Registrant)

Subscribed and sworn to before me this 12th day of February, 1957

My commission expires 11-16-52

John W. Gray
(Notary Public)

(SEAL)

CERTIFICATE OF REGISTRATION

STATE OF OREGON
County of Marion } ss.

This is to certify that the foregoing Registration Statement was received in the office of the State Engineer on the 27th day of February, 1957, at 8:00 o'clock A. M. and has been duly recorded in said office in Book No. 3 of Registration Statements on page GR-365 C.

~~Construction shall be completed on or before ~~ and the water completely applied to a beneficial use by ~~, 19~~

Witness my hand this 30th day of April, 1957

Lewis A. Stanley
(State Engineer)

By
(Deputy)

#15.00

GR 365 C