

STATE ENGINEER
SALEM, OREGON

Registration Statement

OF CLAIMANT OF RIGHT TO APPROPRIATE GROUND WATER

TO THE STATE ENGINEER OF OREGON:

I, ALICE M. MCCOY

of 216 N. GEARY ST. ALBANY County of Linn

State of OREGON do hereby make application for a certificate of registration as evidence of a right to appropriate ground water.

1. Source from which water is withdrawn is PUMP WELL
(Flowing well, pump well, infiltration trench, or tunnel)

2. Location is: 1 1/2 MILES NE OF MARION ORE.
(Approximate distance and direction from nearest city or town)

and is more particularly described as follows:

(a) 1419' N. AND 1716' W. OF SE CORNER S. 22, T. 9S, R. 2W
(Give distance and bearing to corner of section or other legal subdivision)

being within NW 1/4 OF SE 1/4 of Sec. 22, Twp. 9S, Rge. 2W
(Smallest legal subdivision) (N. or S.) (E. or W.)

or (b) within limits of recorded platted property, town or city:

in Lot _____, Block _____ of _____
(Name of plat or addition)

County of Linn Marion
(If within city or town, give name)

3. Construction Work was begun on MARCH 1945; was completed on MAY 1945
(Date) (Date)

and the ground water claimed was first used for the purposes set out below on JULY 1945
(Date)

since which time the water has been used INTERMITTENTLY
(Continuously or intermittently)

from JULY 1945 to PRESENT TIME
(Date) (Date)

4. Quantity of water claimed and used is 300 gallons per minute; 330 acre feet per year.

5. Purpose or Purposes for which water is used IRRIGATION

(Domestic, irrigation, municipal, manufacturing, industrial, etc.)

6. Description of Well: Depth 4 feet. Type DUG
(Dug or drilled)

diameter 35 inches. Elevation of ground at well site 350 feet, mean sea level.
(As near as known)

Depth to water table _____ feet.

7. Capacity of Well: _____ g.p.m. with _____ feet drawdown.

_____ g.p.m. with _____ feet drawdown.

Date of test NOT TESTED

If Flowing Well: Measured discharge _____ g.p.m. on _____
(Date)

Shut-in pressure at ground surface _____ lbs. per sq. in. on _____
(Date)

Water is controlled by _____
(Cap, valve, etc.)

8. Casing: (Give diameter, commercial specifications and depth below ground surface of each casing size.)

36 inch diameter CONCRETE HOLE from to feet
..... inch diameter from to feet
..... inch diameter from to feet
..... inch diameter from to feet

Describe and show depth of shoe, plug, adapter, liner or other details:

9. Perforated Casings or Screens:

N.A.H.E from to
(Number per foot and size of perforations, or describe screen)
..... from to
..... from to
..... from to

10. Log of Well: (Describe each stratum or formation clearly, indicate if water bearing, and give thickness and depth as indicated.)

MATERIAL	Thickness (Feet)	Depth to Bottom (Feet)
<u>NOT AVAILABLE</u>		

If log of well is not available, give name and address of driller. GEO. W. McCoy, 245


11. Infiltration Trench: Covered or open COVERED

Dimensions: Length 9.50 ft. Minimum depth 3 ft. Maximum depth 4 ft.

Bottom width _____ ft. Discharge 3.00 g.p.m. Date of test NOT TESTED

12. Tunnel: Type of lining _____

Dimensions: _____
(Length, course, and cross sectional size)

Position of water bearing stratum with reference to portal of tunnel _____

Log of tunnel: (Preceding table for log of well may be used, if desired. Give footage from portal and character of materials, as pertinent.)

13. Pumping Equipment:

(a) Pump FAIRBANKS MORSE 3" CENT Capacity 30.0 g.p.m.
(Make, type and size)

(b) Motor 20 H.P. ELECTRIC
(Type and horsepower)


14. Location of area irrigated or to be irrigated, or place of use if for purposes other than irrigation.

Township North or South	Range E. or W. of Williamsite Meridian	Section	Forty-acre Tract	Number Acres To Be Irrigated	Date of Reclamation
9S	2W	22	NW 1/4 of SE 1/4	4.0	JULY 1945
9S	2W	22	NE 1/4 of SE 1/4	3.0	" "
9S	2W	22	SW 1/4 of SE 1/4	3.0	" "
9S	2W	22	SE 1/4 of SE 1/4	1.0	" "
				<u>11.0</u>	

15. If the ground water supply is supplemental to an existing water supply, identification of any application for a permit, permit, certificate or adjudicated right to appropriate water made or held by the registrant.

Township 2S Range 2W W.M.

North

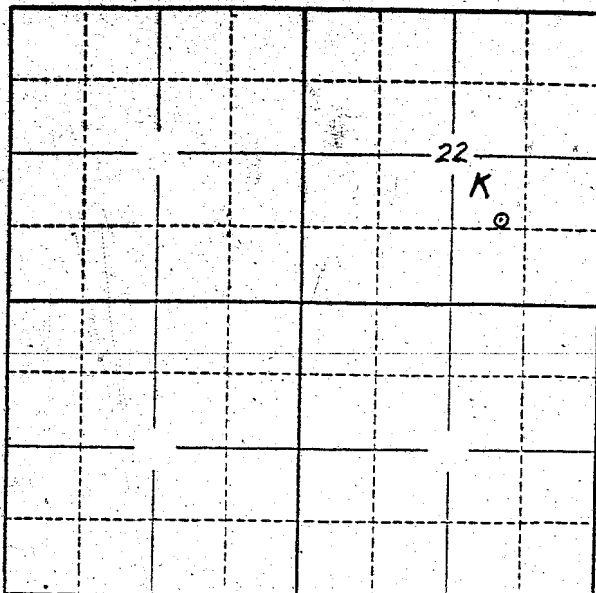

Locate well and acreage of irrigated land on plat.

Scale: 2" = 1 Mile

STATE OF OREGON

County of Linn } ss.

I, Alice M. McCoy being first duly sworn, do hereby certify that I have read the foregoing Registration Statement and that all of the items therein contained are true to the best of my knowledge and belief.

Alice M. McCoy
(Signature of Registrant)

Subscribed and sworn to before me this 31 day of July, 1958

My commission expires MY COMMISSION EXPIRES MAY 22, 1962

Lillian E. Phillip
(Notary Public)

(SEAL)

CERTIFICATE OF REGISTRATION

STATE OF OREGON } ss.
County of Marion,

This is to certify that the foregoing Registration Statement was received in the office of the State Engineer on the 1st day of August, 1958, at 2:00 o'clock A. M. and has been duly recorded in said office in Book No. 14 of Registration Statements on page GR 3455

Witness my hand this 15th day of September, 1959

\$15.00

Lewis A. Stanley
(State Engineer)

By _____
(Deputy)

GR 3455