

Registration Statement

OF CLAIMANT OF RIGHT TO APPROPRIATE GROUND WATER

TO THE STATE ENGINEER OF OREGON:

I, FLOYD R. INGHAM

of RT 4, Box 203, Albany County of BENTON

State of OREGON, do hereby make application for a certificate of registration as evidence of a right to appropriate ground water.

1. Source from which water is withdrawn is PUMP WELL
(Flowing well, pump well, infiltration trench, or tunnel)

2. Location is: 5 MILE N. OF ALBANY, ORE.
(Approximate distance and direction from nearest city or town)

and is more particularly described as follows:

(a) 2320' S. AND 1848' W. OF NE CORNER S. 1, T. 11S, R. 4W
(Give distance and bearing to corner of section or other legal subdivision)

being within SW 1/4 OF NE 1/4 of Sec. 7, Twp. 11S, Rge. 4W
(Smallest legal subdivision) (N. or S.) (E. or W.)

or (b) within limits of recorded platted property, town or city;

in Lot _____, Block _____ of _____
(Name of plat or addition)

County of BENTON
(If within city or town, give name)

3. Construction Work was begun on 1946; was completed on 1946
(Date) (Date)

and the ground water claimed was first used for the purposes set out below on 1946
(Date)

since which time the water has been used CONTINUOUSLY
(Continuously or intermittently)

from 1946 to PRESENT TIME
(Date) (Date)

4. Quantity of water claimed and used is 35 gallons per minute; 6.0 acre feet per year.

5. Purpose or Purposes for which water is used IRRIGATION AND ~~DRINK~~

(Domestic, irrigation, municipal, manufacturing, industrial, etc.)

6. Description of Well: Depth 63 feet. Type DRILLER
(Dug or drilled)

diameter 6 inches. Elevation of ground at well site 200 feet, mean sea level.
(As near as known)

Depth to water table UNKNOWN feet.

7. Capacity of Well: _____ g.p.m. with _____ feet drawdown.

_____ g.p.m. with _____ feet drawdown.

Date of test NOT TESTED

If Flowing Well: Measured discharge _____ g.p.m. on _____
(Date)

Shut-in pressure at ground surface _____ lbs. per sq. in. on _____
(Date)

Water is controlled by _____
(Cap, valve, etc.)

8. Casing: (Give diameter, commercial specifications and depth below ground surface of each casing size.)

6 inch diameter STEEL CASING from 0 to 6.3 feet
..... inch diameter from to feet
..... inch diameter from to feet
..... inch diameter from to feet

Describe and show depth of shoe, plug, adapter, liner or other details:
.....
.....

9. Perforated Casings or Screens:

SLOT PERFORATIONS from 4.3 to 6.3
(Number per foot and size of perforations, or describe screen)
..... from to
..... from to
..... from to

10. Log of Well: (Describe each stratum or formation clearly, indicate if water bearing, and give thickness and depth as indicated.)

MATERIAL	Thickness (Feet)	Depth to Bottom (Feet)
<u>NOT AVAILABLE</u>		

If log of well is not available, give name and address of driller. NICHOLAS KLAOS, INC.,

ALBANY, ORE

11. Infiltration Trench: Covered or open _____
 Dimensions: Length _____ ft. Minimum depth _____ ft. Maximum depth _____ ft.
 Bottom width _____ ft. Discharge _____ g.p.m. Date of test _____


12. Tunnel: Type of lining _____
 Dimensions: _____ (Length, course, and cross sectional size)
 Position of water bearing stratum with reference to portal of tunnel _____

Log of tunnel: (Preceding table for log of well may be used, if desired. Give footage from portal and character of materials, as pertinent.)

13. Pumping Equipment:
 (a) Pump 1 1/2" J.E.F. Capacity 50 g.p.m.
(Make, type and size)
 (b) Motor 2 H.P. ELECTRIC
(Type and horsepower)


14. Location of area irrigated or to be irrigated, or place of use if for purposes other than irrigation.

Township North or South	Range E. or W. of Willamette Meridian	Section	Forty-acre Tract	Number Acres To Be Irrigated	Date of Reclamation
<u>N 15</u>	<u>4W</u>	<u>1</u>	<u>SW 1/4 OF NE 1/4</u>	<u>2.0</u>	<u>1946</u>

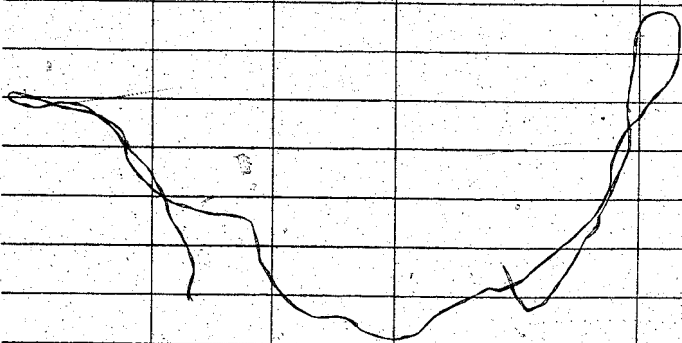

15. If the ground water supply is supplemental to an existing water supply, identification of any application for a permit, permit, certificate or adjudicated right to appropriate water made or held by the registrant.

Township 11 S Range 4 W, W.M.
North

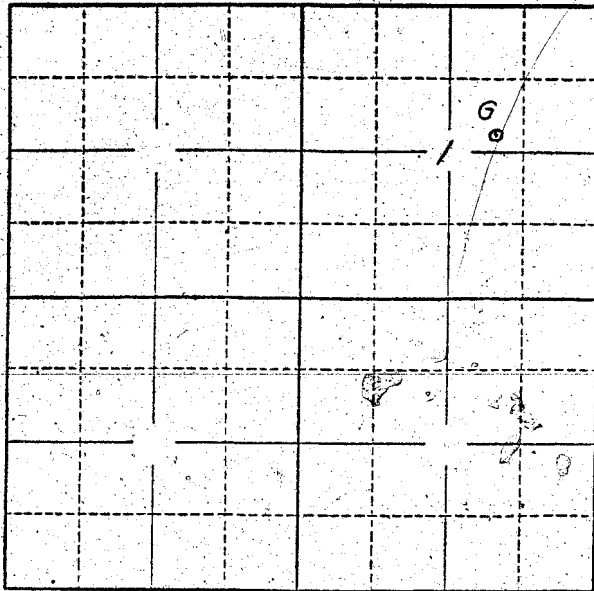

Locate well and acreage of irrigated land on plat.
Scale: 2" = 1 Mile

STATE OF OREGON

County of Linn } ss.

I, FLOYD D. ENGLISH, being first duly sworn, do hereby certify that I have read the foregoing Registration Statement and that all of the items therein contained are true to the best of my knowledge and belief.

Floyd D. English
(Signature of Registrant)

Subscribed and sworn to before me this 30th day of July, 1958.

My commission expires Nov. 7, 1958

Jessie M. Rissman
(Notary Public)

(SEAL)

CERTIFICATE OF REGISTRATION

STATE OF OREGON

County of Marion } ss.

This is to certify that the foregoing Registration Statement was received in the office of the State Engineer on the 1 day of August, 1958, at 8:00 o'clock A. M. and has been duly recorded in said office in Book No. 14 of Registration Statements on page GR-3464.

Witness my hand this 15th day of September, 1959

Lewis A. Stanley
(State Engineer)

By _____
(Deputy)

15.00

GR 3464