Registration No. GR-3807

Certificate No. GR 3469

Registration Statement

OF CLAIMANT OF RIGHT TO APPROPRIATE GROUND WATER

TO THE STATE ENGINEER OF OREGON:

I, Richard C. Eisenbraudt,

of Rt 4 Box 334 Corvallis (Mailing address) County of Linn

State of Oregon, do hereby make application for a certificate of registration as evidence of a right to appropriate ground water.

1. **Source** from which water is withdrawn is Pump Well (Flowing well, pump well, infiltration trench, or tunnel)

2. **Location** is: 3 Miles West of Corvallis (Approximate distance and direction from nearest city or town);

and is more particularly described as follows:

(a) 1122' S AND 1485' E OF NW CORNER S. 5 T 12 S, R 4 W (Give distance and bearing to corner of section or other legal subdivision)

being within NE ¼ OF NW ¼ (Smallest legal subdivision) of Sec. 5, Twp. 12 S (N. or S.), Rge. 4 W (E. or W.)

or (b) within limits of recorded platted property, town or city:

in Lot ....., Block ..... of ..... (Name of plat or addition)

..... (If within city or town, give name) County of Linn

3. **Construction Work** was begun on July 1943 (Date); was completed on July 1943 (Date)

and the ground water claimed was first used for the purposes set out below on July 1943 (Date),

since which time the water has been used ~~intermittently~~ continuously (Continuously or intermittently)

from July 1943 (Date) to ~~July 1947~~ (Date) PRESENT TIME

4. **Quantity** of water claimed and used is 48 gallons per minute; 120 acre feet per year.

5. **Purpose or Purposes** for which water is used Irrigation

(Domestic, irrigation, municipal, manufacturing, industrial, etc.)

6. **Description of Well:** Depth 33 feet. Type Drilled (Dug or drilled)

diameter 2 inches. Elevation of ground at well site 200 (As near as known) feet, mean sea level.

Depth to water table 14 feet.

7. **Capacity of Well:** ..... g.p.m. with ..... feet drawdown.

..... g.p.m. with ..... feet drawdown.

Date of test Not tested

If Flowing Well: Measured discharge ..... g.p.m. on ..... (Date)

Shut-in pressure at ground surface ..... lbs. per sq. in. on ..... (Date)

Water is controlled by ..... (Cap, valve, etc.)

8. **Casing:** (Give diameter, commercial specifications and depth below ground surface of each casing size.)

2 inch diameter Steel Casing from 0 to 33 feet

..... inch diameter ..... from ..... to ..... feet

..... inch diameter ..... from ..... to ..... feet

..... inch diameter ..... from ..... to ..... feet

Describe and show depth of shoe, plug, adapter, liner or other details: .....

9. **Perforated Casings or Screens:**

Screen from 32 to 33
(Number per foot and size of perforations, or describe screen)

..... from ..... to .....

..... from ..... to .....

..... from ..... to .....

10. **Log of Well:** (Describe each stratum or formation clearly, indicate if water bearing, and give thickness and depth as indicated.)

MATERIAL	Thickness (Feet)	Depth to Bottom (Feet)
Not available		

GR 3469

If log of well is not available, give name and address of driller. Unknown

11. Infiltration Trench: Covered or open _____

Dimensions: Length _____ ft. Minimum depth _____ ft. Maximum depth _____ ft.

Bottom width _____ ft. Discharge _____ g.p.m. Date of test _____

12. Tunnel: Type of lining _____

Dimensions: _____
(Length, course, and cross sectional size)

Position of water bearing stratum with reference to portal of tunnel _____

0

Log of tunnel: (Preceding table for log of well may be used, if desired. Give footage from portal and character of materials, as pertinent.)

13. Pumping Equipment:

(a) Pump 2" CENTRIFUGAL (Make, type and size) Capacity 100 g.p.m.

(b) Motor 2 H.P. ELECTRIC (Type and horsepower)

14. Location of area irrigated or to be irrigated, or place of use if for purposes other than irrigation.

Township North or South	Range E. or W. of Willamette Meridian	Section	Forty-acre Tract	Number Acres To Be Irrigated	Date of Reclamation
12 S	4 W	5	NE¼ of NW¼	2.0	July 1943
12 S	4 W	5	SE¼ of NW¼	2.0	" "
				4.0	

15. If the ground water supply is supplemental to an existing water supply, identification of any application for a permit, permit, certificate or adjudicated right to appropriate water made or held by the registrant.

_____

_____

Township 12S Range 4W, W.M.

North

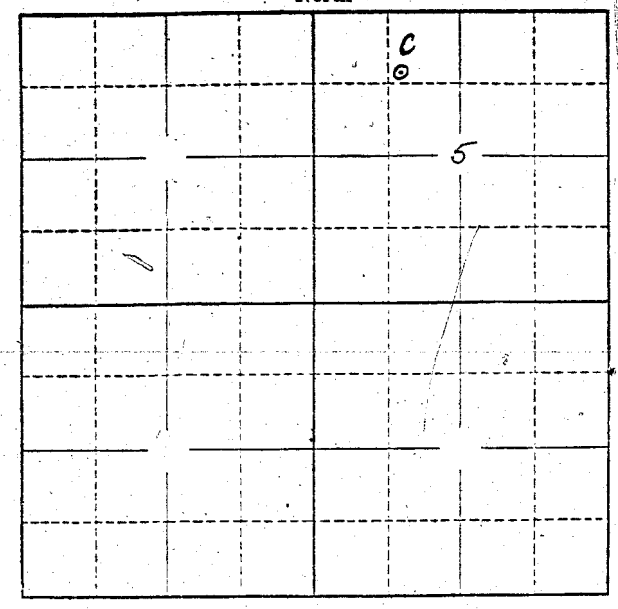

Locate well and acreage of irrigated land on plat.

Scale: 2" = 1 Mile

STATE OF OREGON
County of Linn } ss.

I, Richard C. Eisenbrandt, being first duly sworn, do hereby certify that I have read the foregoing Registration Statement and that all of the items therein contained are true to the best of my knowledge and belief.

Richard C. Eisenbrandt
(Signature of Registrant)

Subscribed and sworn to before me this 30th day of July 1958

My commission expires NOTARY PUBLIC FOR OREGON
My Commission Expires 20 March 1961

W. Walter Stanley
(Notary Public)

(SEAL)

CERTIFICATE OF REGISTRATION

STATE OF OREGON
County of Marion } ss.

A

This is to certify that the foregoing Registration Statement was received in the office of the State Engineer on the 1st day of August, 1958, at 8:00 o'clock A. M. and has been duly recorded in said office in Book No. 14 of Registration Statements on page GR-3469

Witness my hand this 15th day of September, 1959

Lewis A. Stanley
(State Engineer)

$15.00

By
(Deputy)

GR-3469