RECEIVED
FEB 20 1957
STATE ENGINEER
SALEM, OREGON

REGISTRATION NO. GR-381

Registration Statement

CERTIFICATE NO. GR 368

OF CLAIMANT OF RIGHT TO APPROPRIATE GROUND WATER

(Under Chapter 708, Oregon Laws 1955.)

TO THE STATE ENGINEER OF OREGON:

~~I~~ x We, Roy L. Snyder and Ruth Snyder

of Rt. 2, Box 289, Eugene County of Lane

State of Oregon, do hereby make application for a certificate of registration as evidence of a right to appropriate ground water.

1. **Source from which water is withdrawn is** pump well (Flowing well, pump well, infiltration trench, or tunnel)

2. **Location is:** 5½ miles Northeast of Eugene (Approximate distance and direction from nearest city or town);

and is more particularly described as follows: Beginning at a point 2640 ft. East and 896.36 ft. South of the quarter section corner between sections 9 and 10, T17 S, R3 W W.M. running thence South ~~(a) 297.52 ft., thence West 1463.8 ft., thence North 297.52 ft. and thence East 1463.8~~ ft. to the place of beginning, all in Lane County, Oregon. (Give distance and bearing to corner of section or other legal subdivision)

1341.7 feet east and 907.36 feet south from W ¼ corner 10

being within NE¼ of SW¼ (Smallest legal subdivision) of Sec. 10, Twp. 17 S (N. or S.), Rge. 3 W (E. or W.)

or (b) within limits of recorded platted property, town or city:

in Lot ....., Block ..... of ..... (Name of plat or addition)

..... (If within city or town, give name) County of .....

3. **Construction Work** was begun on 1950 (Date); was completed on 1950 (Date)

and the ground water claimed was first used for the purposes set out below on 1950 (Date),

since which time the water has been used continuously during irrigation season (Continuously or intermittently)

from 1950 (Date) to date (Date)

4. **Quantity** of water claimed and used is 150 gallons per minute; ..... acre feet per year.

5. **Purpose or Purposes** for which water is used irrigation

..... (Domestic, irrigation, municipal, manufacturing, industrial, etc.)

6. **Description of Well:** Depth 20 feet. Type driven (Dug or drilled)
(2 driven pipes making 1 well--each pipe 2 inches in diameter.
diameter ..... inches. Elevation of ground at well site approx. 430 (As near as known) feet, mean sea level.

Depth to water table 8 feet.

7. **Capacity of Well:** 150 g.p.m. with ..... feet drawdown.

..... g.p.m. with ..... feet drawdown.

Date of test 1950

If Flowing Well: Measured discharge ..... g.p.m. on ..... (Date)

Shut-in pressure at ground surface ..... lbs. per sq. in. on ..... (Date)

Water is controlled by ..... (Cap, valve, etc.)

8. **Casing:** (Give diameter, commercial specifications and depth below ground surface of each casing size.) 2 galvanized pipes driven, 2 inches in diameter approximately 5 feet apart, each driven approximately 20 feet deep.

..... inch diameter ..... from ..... to ..... feet

..... inch diameter ..... from ..... to ..... feet

..... inch diameter ..... from ..... to ..... feet

..... inch diameter ..... from ..... to ..... feet

Describe and show depth of shoe, plug, adapter, liner or other details: .....

9. **Perforated Casings or Screens:**

Each pipe perforated with 3/8" holes, approximately 36 inches at the bottom of each pipe.

..... from ..... to .....
(Number per foot and size of perforations, or describe screen)

..... from ..... to .....

..... from ..... to .....

..... from ..... to .....

10. **Log of Well:** (Describe each stratum or formation clearly, indicate if water bearing, and give thickness and depth as indicated.)

MATERIAL	Thickness (Feet)	Depth to Bottom (Feet)

2. Location is: 5½ miles northeast of Eugene, Oregon, and is more particularly described as follows:

Beginning at the most Southeasterly corner of Jacob C. Sporee D.L.C.#38, in Sec. 10, T17S, R3W,W.M., thence West along the southerly boundary of said D.L.C.#38, 11.63 chains to a point which is 9.75 chains south of the section corner common to Sections 3,4,9 and 10, in said township and range, and which point is the Northeasterly corner of Elijah W. Rhea D.L.C.#44; thence South on the section line between Sections 9 and 10, 30.25 chains to the quarter section corner; thence East along the quarter section line of Section 10, 1341.7 feet; thence South 907.36 feet to site of well, the well site being within the NE¼SW¼ and located upon a tract of land described as follows: of Sec. 10,T17S,R3W,WM.

Beginning at a point 2640 feet East and 896.36 feet South of the quarter section corner between Sections 9 and 10, T17S, R3W, W.M., and running thence South 297.52 feet, thence West 1463.8 feet, thence North 297.52 feet, and thence East 1463.8 feet, to the place of beginning, in Lane County, Oregon

If log of well is not available, give name and address of driller. D. D. Dickenson, 1280 River Road, Eugene, Oregon

11. **Infiltration Trench:** Covered or open none

Dimensions: Length ..... ft. Minimum depth ..... ft. Maximum depth ..... ft.

Bottom width ..... ft. Discharge ..... g.p.m. Date of test .....

12. **Tunnel:** Type of lining none

Dimensions: ..... (Length, course, and cross sectional size)

Position of water bearing stratum with reference to portal of tunnel .....

Log of tunnel: (Preceding table for log of well may be used, if desired. Give footage from portal and character of materials, as pertinent.)

13. **Pumping Equipment:**

(a) Pump Montgomery-Ward (Make, type and size) Capacity 150 g.p.m.

(b) Motor 5 h.p. electric (Type and horsepower)

14. Location of area irrigated or to be irrigated, or place of use if for purposes other than irrigation.

Township North or South	Range E. or W. of Willamette Meridian	Section	Forty-acre Tract	Number Acres To Be Irrigated	Date of Reclamation
17 S	3 W	10	NE¼SW¼	9.02 Acres	1950
17 S	3 W	10	NW¼SW¼	.98 Acres	
				10.00	

15. If the ground water supply is supplemental to an existing water supply, identification of any application for a permit, permit, certificate or adjudicated right to appropriate water made or held by the registrant.

none

GR 368 B

Township 17S Range 3 W W.M.

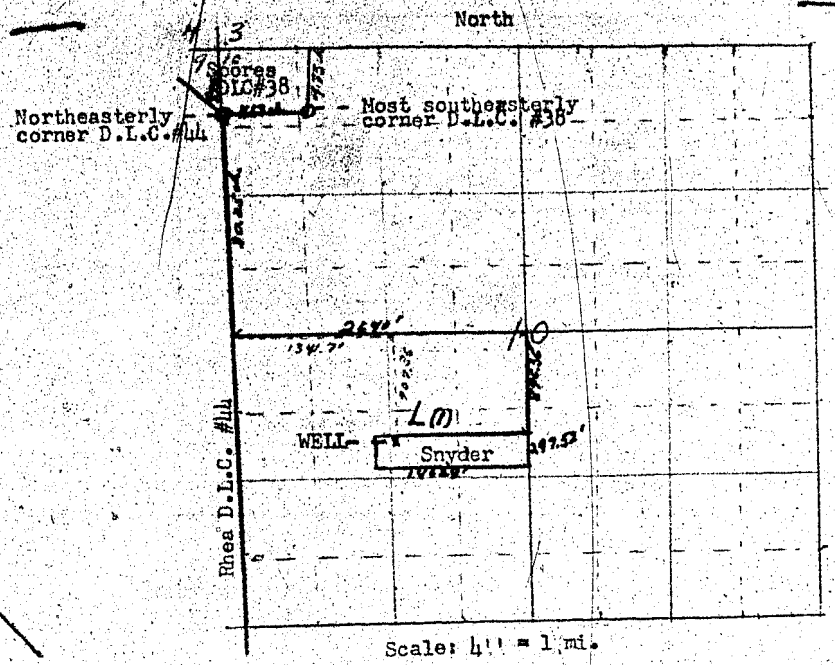

STATE OF OREGON
County of Lane } ss.

We, Roy L. Snyder and Ruth Snyder, being first duly sworn, do hereby certify that we have read the foregoing Registration Statement and that all of the items therein contained are true to the best of our knowledge and belief.

Roy L. Snyder
Ruth Snyder
(Signature of Registrant)

Subscribed and sworn to before me this 23rd day of February, 1957.

My commission expires March 26, 1959

Judith S. Mac Innis
(Notary Public) for Oregon

(SEAL)

CERTIFICATE OF REGISTRATION

STATE OF OREGON
County of Marion } ss.

This is to certify that the foregoing Registration Statement was received in the office of the State Engineer on the 28th day of February, 1957, at 8:00 o'clock A. M. and has been duly recorded in said office in Book No. 3 of Registration Statements on page GR-368 C

~~Construction shall be completed by X-X-X-X-X-X-X-X-X-X, 19X-X, and the water completely applied to X-X-X-X-X-X-X-X-X-X-X-X-X-X-X-X-X-X-X-X-X-X, 19X-X-X~~

Witness my hand this 30th day of April, 1957

Lewis A. Stanley
(State Engineer)

$15.00

By
(Deputy)

GR 368 C