Registration No. GR-3810

Certificate No. GR 3472

Registration Statement

OF CLAIMANT OF RIGHT TO APPROPRIATE GROUND WATER

TO THE STATE ENGINEER OF OREGON:

I, WILLIAM CLIFFORD VAN COTT,

of 15455 SW 72nd ave. Tigard 23 Ore. (Mailing address) County of WASHINGTON

State of OREGON, do hereby make application for a certificate of registration as evidence of a right to appropriate ground water.

1. **Source** from which water is withdrawn is PUMP WELL (Flowing well, pump well, infiltration trench, or tunnel)

2. **Location** is: 2 MILES SOUTHEAST OF TIGARD (Approximate distance and direction from nearest city or town);

and is more particularly described as follows:

(a) 1400 feet west & 1470 feet north from SE corner Section 12, T2S, R1W. (Give distance and bearing to corner of section or other legal subdivision)

being within NW¼ of SE¼ (Smallest legal subdivision) of Sec. 12, Twp. 2S (N. or S.), Rge. 1W (E. or W.)

or (b) within limits of recorded platted property, town or city:

in Lot 29, Block ..... of ZANNO CREEK ACRE TRACTS (Name of plat or addition)

..... (If within city or town, give name) County of WASHINGTON

3. **Construction Work** was begun on SEPT 11 1951 (Date); was completed on SEPT 20 1951 (Date)

and the ground water claimed was first used for the purposes set out below on JULY 19 1952 (Date),

CONTINUOUSLY AS HOME SUPPLY

since which time the water has been used EACH SUMMER FOR IRRIGATION (Continuously or intermittently)

from SEPT 20 1951 (Date) to JULY 28 1958 (Date)

4. **Quantity** of water claimed and used is 9 gallons per minute; 1.21 acre feet per year.

5. **Purpose or Purposes** for which water is used IRRIGATION

(Domestic, irrigation, municipal, manufacturing, industrial, etc.)

6. **Description of Well:** Depth 29 feet. Type DUG (Dug or drilled)

diameter 33 inches. Elevation of ground at well site 109 (As near as known) feet, mean sea level.

Depth to water table 12 feet.

7. **Capacity of Well:** 8 g.p.m. with 7.5 feet drawdown.

142 g.p.m. with 14 feet drawdown.

Date of test SEPT 17, 1951

If Flowing Well: Measured discharge ..... g.p.m. on ..... (Date)

Shut-in pressure at ground surface ..... lbs. per sq. in. on ..... (Date)

Water is controlled by ..... (Cap, valve, etc.)

8. **Casing:** (Give diameter, commercial specifications and depth below ground surface of each casing size.)

_____ inch diameter _____ from _____ to _____ feet

_____ inch diameter _____ from _____ to _____ feet

_____ inch diameter _____ from _____ to _____ feet

_____ inch diameter _____ from _____ to _____ feet

Describe and show depth of shoe, plug, adapter, liner or other details: _____

_____

_____

9. **Perforated Casings or Screens:**

_____ from _____ to _____
(Number per foot and size of perforations, or describe screen)

_____ from _____ to _____

_____ from _____ to _____

_____ from _____ to _____

10. **Log of Well:** (Describe each stratum or formation clearly, indicate if water bearing, and give thickness and depth as indicated.)

MATERIAL	Thickness (Feet)	Depth to Bottom (Feet)

GR 3472

If log of well is not available, give name and address of driller. CHARLES MYERS

17980 S.W. LOWER BOONES FERRY RD. LAKE GROVE, ORE.

11. **Infiltration Trench:** Covered or open

Dimensions: Length ______ ft. Minimum depth ______ ft. Maximum depth ______ ft.

Bottom width ______ ft. Discharge ______ g.p.m. Date of test

12. **Tunnel:** Type of lining

Dimensions: ______ (Length, course, and cross sectional size)

Position of water bearing stratum with reference to portal of tunnel

Log of tunnel: (Preceding table for log of well may be used, if desired. Give footage from portal and character of materials, as pertinent.)

13. **Pumping Equipment:**

(a) Pump PACIFIC PUMP CO. (Make, type and size) Capacity 15 g.p.m.

(b) Motor GE 120 V SINGLE PHASE VERTICAL ½ H.P. (Type and horsepower)

14. Location of area irrigated or to be irrigated, or place of use if for purposes other than irrigation.

Township North or South	Range E. or W. of Willamette Meridian	Section	Forty-acre Tract	Number Acres To Be Irrigated	Date of Reclamation
T 2 South	1 WEST	12	LOT 43 and 44 [illegible] NW¼ of SE¼ [illegible] Tracts	4.0	1952
			[illegible] LOT 21		
			[illegible] SOUTH SIDE		

15. If the ground water supply is supplemental to an existing water supply, identification of any application for a permit, permit, certificate or adjudicated right to appropriate water made or held by the registrant.

GR 3472

Township 2 South Range 1 WEST, W.M.

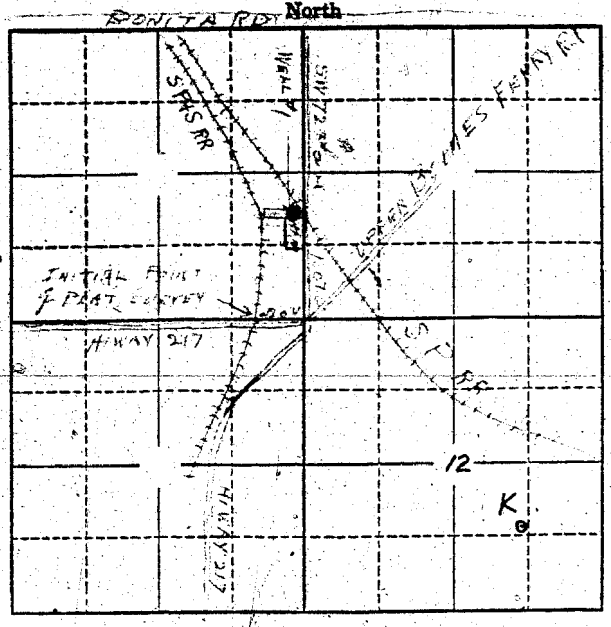

WELL LOCATED ON LOT 24 150 FEET south of intersection of SW 72nd ave and Upper Boones Ferry Rd.

AREA TO BE IRRIGATED (3.96 acres) is LOTS 43 + 44 (next South)

Locate well and acreage of irrigated land on plat.

Scale: 2" — 1 Mile

STATE OF OREGON
County of Washington } ss.

I, W. C. Vanatta, being first duly sworn, do hereby certify that I have read the foregoing Registration Statement and that all of the items therein contained are true to the best of my knowledge and belief.

W C Vanatta
(Signature of Registrant)

Subscribed and sworn to before me this 31 day of July 1958

My commission expires 9-24-58

Eloyce E. Thompson
(Notary Public)

(SEAL)

NOTARY PUBLIC FOR OREGON
My Commission Expires Sept. 24, 1958

CERTIFICATE OF REGISTRATION

STATE OF OREGON
County of Marion } ss.

This is to certify that the foregoing Registration Statement was received in the office of the State Engineer on the 1st day of August, 1958, at 10.30 o'clock A. M. and has been duly recorded in said office in Book No. 14 of Registration Statements on page GR-3472.

Witness my hand this 15th day of September 1959

Lewis A. Stanley
(State Engineer)

$15.00

By
(Deputy)

GR 3472