

# Registration Statement

## OF CLAIMANT OF RIGHT TO APPROPRIATE GROUND WATER

TO THE STATE ENGINEER OF OREGON:

I, Howard S. Murray

of Milton-Freewater, RT#3.143 County of Umatilla

State of Oregon, do hereby make application for a certificate of registration as evidence of a right to appropriate ground water.

1. Source from which water is withdrawn is Dug well

(Flowing well, pump well, infiltration trench, or tunnel)

2. Location is: Approx. 4 miles from Milton-Freewater, N.E.

(Approximate distance and direction from nearest city or town)

and is more particularly described as follows:

(a) 365 ft. East from apoint 345 ft. N. from the SW Cor of NW 1/4 of NE 1/4

(Give distance and bearing to corner of section or other legal subdivision)

being within NW 1/4 of NE 1/4 of Sec. 24, Twp. 6 N., Rge. 35 E.

(Smallest legal subdivision)

(N. or S.)

(E. or W.)

or (b) within limits of recorded platted property, town or city:

in Lot \_\_\_\_\_, Block \_\_\_\_\_ of \_\_\_\_\_

(Name of plat or addition)

County of Umatilla

(If within city or town, give name)

3. Construction Work was begun on Between 1920 and 1927, was completed on Before 1927

(Date)

(Date)

and the ground water claimed was first used for the purposes set out below on Before 1927.

(Date)

since which time the water has been used Used most of the time.

(Continuously or intermittently)

from before 1927 to 1957

(Date)

(Date)

4. Quantity of water claimed and used is 300 gallons per minute; 312 acre feet per year.

5. Purpose or Purposes for which water is used Irrigation.

(Domestic, irrigation, municipal, manufacturing, industrial, etc.)

6. Description of Well: Depth 30 feet. Type Dug well 5'X5' cement curb 15' D.

(Dug or drilled)

diameter \_\_\_\_\_ inches. Elevation of ground at well site approx. 780 ft. feet, mean sea level.

(As near as known)

Depth to water table 20 feet.

7. Capacity of Well: 300 g.p.m. with unknown feet drawdown.

\_\_\_\_\_ g.p.m. with \_\_\_\_\_ feet drawdown.

Date of test not known about any test.

If Flowing Well: Measured discharge \_\_\_\_\_ g.p.m. on \_\_\_\_\_

(Date)

Shut-in pressure at ground surface \_\_\_\_\_ lbs. per sq. in. on \_\_\_\_\_

(Date)

Water is controlled by \_\_\_\_\_


(Cap, valve, etc.)





Township 6N Range 35E, W.M.  
North

*Well*

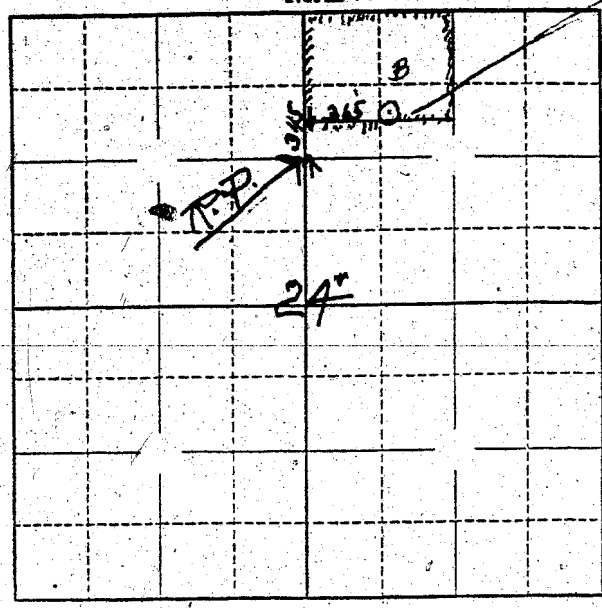

Locate well and acreage of irrigated land on plat.

Scale:  $\frac{1}{4}$ " = 1 Mile  
 $4" = 1 \text{ Mile}$

STATE OF OREGON

County of Umatilla } ss.

I, Howard S. Murray, being first duly sworn, do hereby certify that I have read the foregoing Registration Statement and that all of the items therein contained are true to the best of my knowledge and belief.

*Howard S. Murray*  
(Signature of Registrant)

Subscribed and sworn to before me this 30 day of July, 1958.

My commission expires May 7, 1961

*Howard S. Murray*  
Notary Public for Oregon  
My Commission Expires May 7, 1961

(SEAL)

**CERTIFICATE OF REGISTRATION**

STATE OF OREGON

County of Marion } ss.

This is to certify that the foregoing Registration Statement was received in the office of the State Engineer on the 1st day of August, 1958, at 2:00 o'clock A.M. and has been duly recorded in said office in Book No. 14 of Registration Statements on page GR 3473

Witness my hand this 15th day of September, 1959

*Laura A. Ottaway*  
(State Engineer)

*1500*

By \_\_\_\_\_ (Deputy)

GR 3473