

# Registration Statement

## OF CLAIMANT OF RIGHT TO APPROPRIATE GROUND WATER

TO THE STATE ENGINEER OF OREGON:

I, Cornelia Dean Van Hees  
of Box 272B Silverton County of Mason  
(Mailing address)

State of Oregon, do hereby make application for a certificate of registration as evidence of a right to appropriate ground water.

- 1. Source from which water is withdrawn is Pump well  
(Flowing well, pump well, infiltration trench, or tunnel)
- 2. Location is: West of Mt Angel, Oregon  
(Approximate distance and direction from nearest city or town)

and is more particularly described as follows:

(a) 1590 feet east & 100 feet north from NW corner Section 18  
(Give distance and bearing to corner of section or other legal subdivision)  
being within S 1/4 of NW 1/4 of Sec. 18, Twp. 6S, Rge. 1W  
(Smallest legal subdivision) (N. or S.) (E. or W.)

or (b) within limits of recorded platted property, town or city:  
in Lot \_\_\_\_\_, Block \_\_\_\_\_ of \_\_\_\_\_  
(Name of plat or addition)

County of \_\_\_\_\_  
(If within city or town, give name)

3. Construction Work was begun on Feb. 25, 1951, was completed on March 1, 1951  
(Date) (Date)  
and the ground water claimed was first used for the purposes set out below on March 1951  
(Date)  
since which time the water has been used Intermittently  
(Continuously or Intermittently)  
from 1951 to Oct 1957  
(Date) (Date)

4. Quantity of water claimed and used is 120 gallons per minute; \_\_\_\_\_ acre feet per year.

5. Purpose or Purposes for which water is used \_\_\_\_\_

Irrigation  
(Domestic, irrigation, municipal, manufacturing, industrial, etc.)

6. Description of Well: Depth 101 feet. Type Drilled  
(Dug or drilled)  
diameter 6 inches. Elevation of ground at well site \_\_\_\_\_ feet, mean sea level.  
(As near as known)  
Depth to water table \_\_\_\_\_ feet.

7. Capacity of Well: \_\_\_\_\_ g.p.m. with \_\_\_\_\_ feet drawdown.  
\_\_\_\_\_ g.p.m. with \_\_\_\_\_ feet drawdown.

Date of test \_\_\_\_\_

If Flowing Well: Measured discharge \_\_\_\_\_ g.p.m. on \_\_\_\_\_  
(Date)

Shut-in pressure at ground surface \_\_\_\_\_ lbs. per sq. in. on \_\_\_\_\_  
(Date)

Water is controlled by \_\_\_\_\_  
(Cap, valve, etc.)

8. Casing: (Give diameter, commercial specifications and depth below ground surface of each casing size.)

6 inch diameter *steel casing* from 0 to 101 feet  
 inch diameter from to feet  
 inch diameter from to feet  
 inch diameter from to feet

Describe and show depth of shoe, plug, adapter, liner or other details:

9. Perforated Casings or Screens:

*No* (Number per foot and size of perforations, or describe screen) from to  
 from to  
 from to  
 from to

10. Log of Well: (Describe each stratum or formation clearly, indicate if water bearing, and give thickness and depth as indicated.)

MATERIAL	Thickness (Feet)	Depth to Bottom (Feet)
<i>soil</i>	<i>0</i>	<i>5</i>
<i>Sub Soil - Shat Clay</i>	<i>5</i>	<i>35</i>
<i>Dark Blue fine sand</i>		<i>35</i>
<i>Sand</i>	<i>35</i>	<i>51</i>
<i>Blue Clay</i>		<i>51</i>
<i>Blue Clay</i>	<i>51</i>	<i>73</i>
<i>Brown Shale</i>	<i>73</i>	<i>93</i>
<i>Sand stone</i>	<i>93</i>	<i>95</i>
<i>Gravel (younger also)</i>	<i>95</i>	<i>101</i>

If log of well is not available, give name and address of driller.

Carl H Saunders

11. Infiltration Trench: Covered or open \_\_\_\_\_

Dimensions: Length \_\_\_\_\_ ft. Minimum depth \_\_\_\_\_ ft. Maximum depth \_\_\_\_\_ ft.

Bottom width \_\_\_\_\_ ft. Discharge \_\_\_\_\_ g.p.m. Date of test \_\_\_\_\_

12. Tunnel: Type of lining \_\_\_\_\_

Dimensions: \_\_\_\_\_  
(Length, course, and cross sectional size)

Position of water bearing stratum with reference to portal of tunnel \_\_\_\_\_

Log of tunnel: (Preceding table for log of well may be used, if desired. Give footage from portal and character of materials, as pertinent.)

13. Pumping Equipment:

(a) Pump \_\_\_\_\_ Turbine \_\_\_\_\_ Capacity \_\_\_\_\_ g.p.m.  
(Make, type and size)


(b) Motor B.F. 5HP. \_\_\_\_\_  
(Type and horsepower) Jagunji

14. Location of area irrigated or to be irrigated, or place of use if for purposes other than irrigation.

Township North or South	Range E. or W. of Williamsite Meridian	Section	Forty-acre Tract	Number Acres To Be Irrigated	Date of Reclamation
T6S	R1W	18	SW <sup>1</sup> / <sub>4</sub> of NW <sup>1</sup> / <sub>4</sub>	1.2	1951
"	"	"	SE <sup>1</sup> / <sub>4</sub> of NW <sup>1</sup> / <sub>4</sub>	2.8	"
"	"	"	NW <sup>1</sup> / <sub>4</sub> of SW <sup>1</sup> / <sub>4</sub>	2.8	"
"	"	"	NE <sup>1</sup> / <sub>4</sub> of SW <sup>1</sup> / <sub>4</sub>	5.5	"
				<u>12.6</u>	"

15. If the ground water supply is supplemental to an existing water supply, identification of any application for a permit, permit, certificate or adjudicated right to appropriate water made or held by the registrant.

Township 6S Range 1W, W.M.  
North

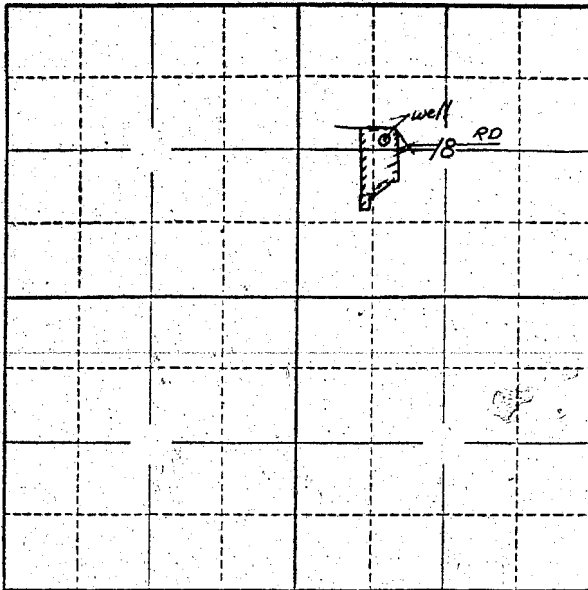

Locate well and acreage of irrigated land on plat.  
Scale: 2" = 1 Mile

STATE OF OREGON

County of Marion } ss.

I, Cornelia Dean Van Ness, being first duly sworn, do hereby certify that I have read the foregoing Registration Statement and that all of the items therein contained are true to the best of my knowledge and belief.

Cornelia Dean Van Ness  
(Signature of Registrant)

Subscribed and sworn to before me this 1st day of August, 1958

My commission expires 12th June 1961 Wm. S. Bartholomew  
(Notary Public)

(SEAL)

**CERTIFICATE OF REGISTRATION**

STATE OF OREGON } ss.  
County of Marion

This is to certify that the foregoing Registration Statement was received in the office of the State Engineer on the 1st day of August, 1958, at 4:20 o'clock P. M. and has been duly recorded in said office in Book No. 14 of Registration Statements on page GR-3479

Witness my hand this 15th day of September, 1959

\$15.00

Lewis A. Stanley  
(State Engineer)

By \_\_\_\_\_ (Deputy)

GR. 3479